

KANSAS

Ellsworth


Form 51—5M—7-39—Palace

Section 6 Township 16 Range 10-W

Well No. #1 Hasha

Company Aylward Prod. et al

NORTH Stoltenberg Pool

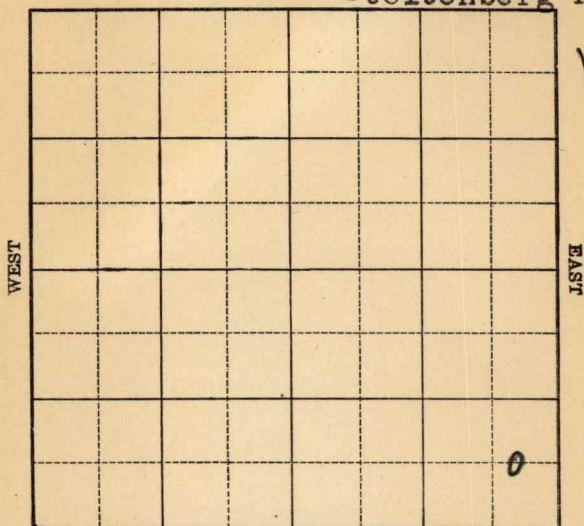

KANSAS

Ellsworth

Sec. 6 Twp. 16 R. 10-W

Well No. #1 Hasha Farm

Aylward Prod. et al Company

(Stoltenberg)


Ft. from N. Line

660 Ft. from S. Line

330 Ft. from E. Line

Ft. from W. Line


Elev. 1805

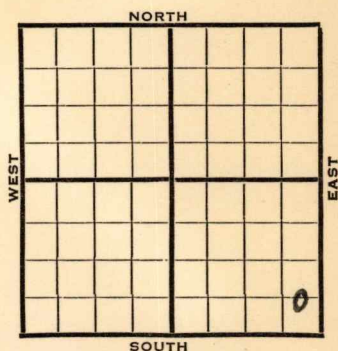

1940	REPORT
4/24	Location
5/2	R.U.R.
5/9	10" - 245' WOC.
5/18	Anhy 595' Drlg. 2190'
5/23	Lans. 2965' Arb. ³²⁷⁴ 3275 -76' TD
	Run pipe.
5/29	Arb. 3274' (Corrected)
	5" - 3274' T.D. 3292'
	200' oil 3 hrs. 42.5 Gravity
6/5	Arb. 3274'
	5" - 3274'
	T.D. 3292'
	3200 acid.
	Depthograph potential 2321 bbls.
	COMPLETED

Ellsworth **KANSAS**Map No. 55 Sec. 6 Twp. 16 R. 10WWell No. 1 HashaAylward Prod. etal Company

Contractor

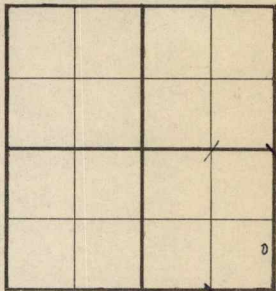FIRST REPORT**SECTION PLAT****C E L S E S E** Ft. from N. Line660 Ft. from S. Line380 Ft. from E. Line Ft. from W. Line**STOLTENBERG POOL**Location XRig up

Drilling and Remarks:

RECORDCased in., ft.Sand Gas Oil Total Depth **PRODUCTION**1st 24 hrs. Nat. 1st 24 hrs. after shot Gas Cu. Ft.Dry Hole Abandoned

Date

APR 24 1940 19S. J. LEWIS Scout

Map No. 55 Sec. 6 Twp. 16 R. 10WWell No. 1 HashaAylward Prod. etal Company

Contractor

COMPLETED

C E L S E S E

 Ft. from N. Line660 Ft. from S. Line380 Ft. from E. Line Ft. from W. Line

SECTION PLAT

			o

STOLTENBERG POOL

Location Rig up

Drilling and Remarks:

*Cor 83274**5" C 3274**3200 acid**Geothogaph 204**2321*

RECORD

Cased in., ft.Sand Gas Oil Total Depth 3292

PRODUCTION

1st 24 hrs. Nat. 1st 24 hrs. after shot Gas Cu. Ft.Dry Hole Abandoned

Date

JUN 5 1940 19

S. J. LEWIS

Scout