

**KANSAS**


Ellsworth

FORM 51 5M 1-42 PETROL

Section 6 Township 16 Range 10-W

Well No. #1 Purma

Company Vickers

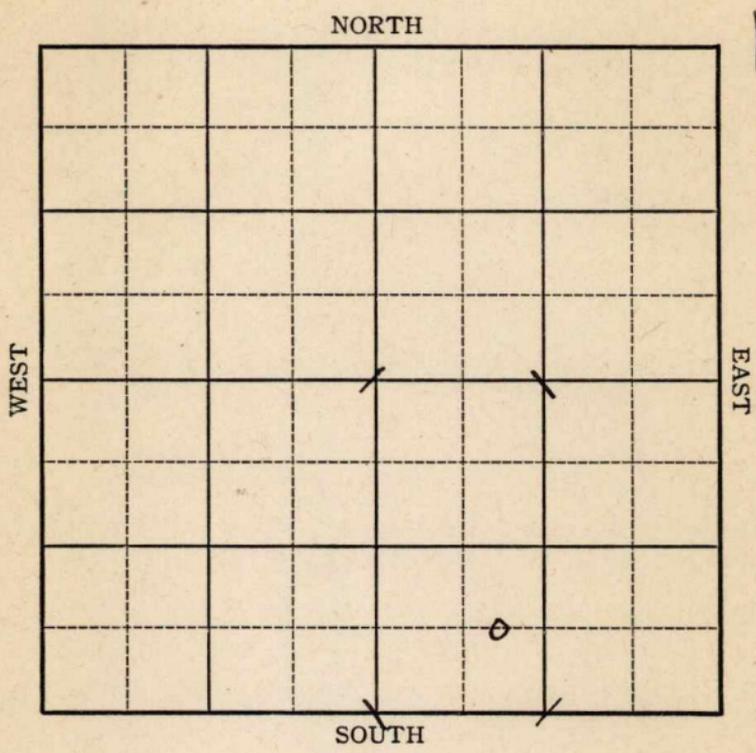

**KANSAS**

Ellsworth

Sec. 6 Twp. 16 R. 10-W

Well No. #1 Purma Farm

Vickers Company


Stoltenberg

\_\_\_\_\_ Ft. from N. Line

660 Ft. from S. Line

\_\_\_\_\_ Ft. from E. Line

990 Ft. from W. Line

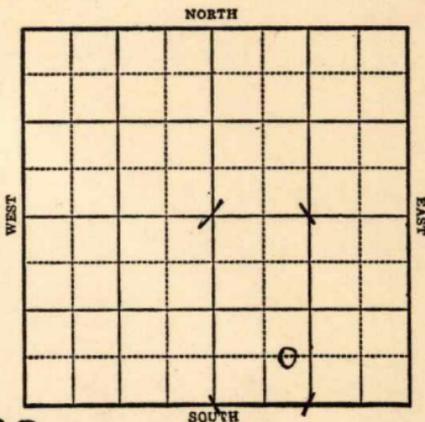

*Elev. 1822*

1943

R E P O R T

6/23 Location.

6/30 Rotary

7/7 10" @ 322'  
Drig. 1870'

7/14 **Arb. 3305**  
T.D. 3310'  
No shows.

**ABANDONED**

**KANSAS**

**Ellsworth**

Map No. 55 Sec. 6 Twp. 16 R. 10W

Well No. 1 Purma

**Vickers**

Company

FIRST REPORT

Contractor

**C E L S W S E**


**SECTION PLAT**

\_\_\_\_\_ Ft. from N. Line

660 Ft. from S. Line

\_\_\_\_\_ Ft. from E. Line

990 Ft. from W. Line

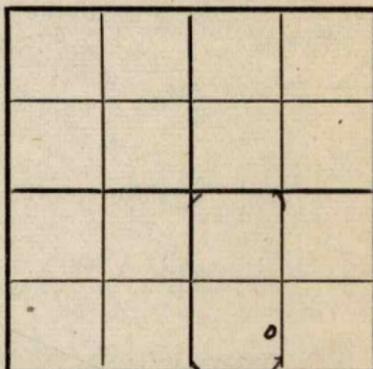

**STOLTENBERG POOL**

Location XXX

Rig up \_\_\_\_\_

Drilling and Remarks:

**RECORD**

Cased \_\_\_\_\_ in., \_\_\_\_\_ ft.

Sand \_\_\_\_\_

Gas \_\_\_\_\_

Oil \_\_\_\_\_

Total Depth \_\_\_\_\_

**PRODUCTION**

1st 24 hrs. Nat. \_\_\_\_\_

1st 24 hrs. after shot \_\_\_\_\_

Gas \_\_\_\_\_ Cu. Ft.

Dry Hole \_\_\_\_\_

Abandoned \_\_\_\_\_

Date

JUN 23 1943 19

S. J. LEWIS Scout

Ellsworth

*KANSAS*  
 Map No. 5 Sec. 6 Twp. 16 R. 10W

Well No. 1 PurmaVickers

Company

ABANDONED

Contractor

C E L S W S E

SECTION PLAT

         Ft. from N. Line660 Ft. from S. Line         Ft. from E. Line990 Ft. from W. Line

		o	

STOLTENBERG POOLLocation                                 Rig up                                 

Drilling and Remarks:

*Cor & 3305*  
*No shows*

## RECORD

Cased          in.,          ft.Sand                                 Gas                                 Oil                                 Total Depth 3910

## PRODUCTION

1st 24 hrs. Nat.                         1st 24 hrs. after shot                         Gas                          Cu. Ft.Dry Hole                                 Abandoned                                 

Date

JUL 14 1943 19S. J. LEWIS Scout