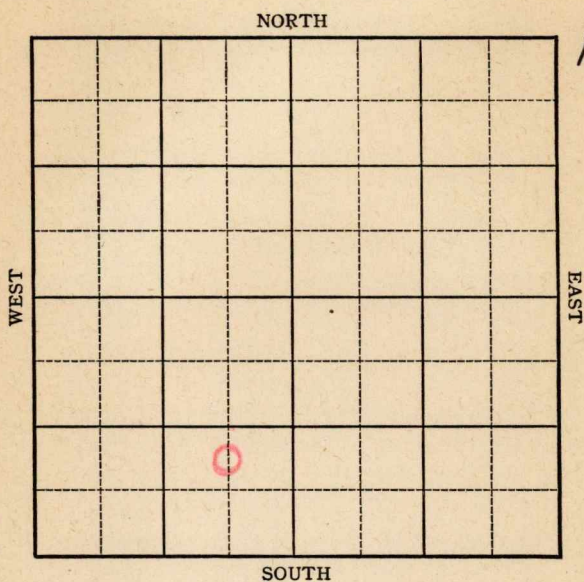


KANSAS

Willsworth county

Section 5 Township 16 Range 10WWell No. #5, HaskaCompany Magnolia

**KANSAS**

Ellsworth County

Sec. 5 Twp. 16 R. 10W

Well No. #5 Haska Farm

Magnolia Company

**Stoltenberg**

Ft. from N. Line


990

Ft. from S. Line

660

Ft. from E. Line

Ft. from W. Line

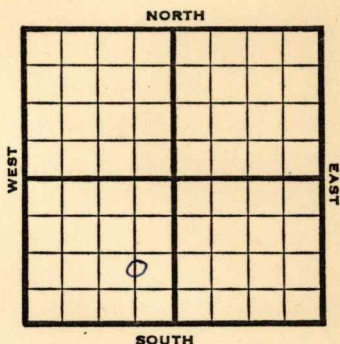

CNL SE SW

1946 **Elev. 1781** REPORT

4/17 Location

4/23 8" @ 932 WOC

5/1 Drlg 2910'

5/7 **Lans 2916**  
**Arb 3251-52** TD  
5" @ 3252 RUST

5/15 **Arb. 3251**

5" @ 3252

500 acid.

TD 3256'

Pump 308 Pot.

Grav. 42.0

**COMPLETED**

**KANSAS**Kansas Pool Name StoltenbergMap No. 55 Sec. 5 Twp. 16 R. 10WWell No. 5 HaskaMagnolia

Company

**FIRST REPORT**

Contractor

C N L SE SW

**SECTION PLAT**

|  |   |  |  |
|--|---|--|--|
|  |   |  |  |
|  |   |  |  |
|  |   |  |  |
|  | o |  |  |

       Ft. from N. Line990 Ft. from S. Line660 Ft. from E. Line       Ft. from W. LineEllsworth CountyLocation XRig up       

Drilling and Remarks:

**RECORD**Cased        in.,        ft.Sand       Gas       Oil       Total Depth       **PRODUCTION**1st 24 hrs. Nat.       1st 24 hrs. after shot       Gas        Cu. Ft.Dry Hole       Abandoned       

Date

APR 17 1946 19S. J. LEWIS

Scout

**KANSAS**Kansas Pool Name Stoltenberg PoolMap No. 53 Sec. 5 Twp. 16 R. 10WWell No. 5 HaskaMagnolia CompanyCOMPLETED Contractor

C N L SE SW

E 1, 1781  
SECTION PLAT       Ft. from N. Line990 Ft. from S. Line       Ft. from E. Line660 Ft. from W. Line

|  |   |  |  |
|--|---|--|--|
|  |   |  |  |
|  |   |  |  |
|  |   |  |  |
|  | 0 |  |  |

Ellsworth CountyLocation                     Rig up                     

Drilling and Remarks:

Art 32515" @ 3252500 acidPump 308 R & X42 2/3

## RECORD

Cased        in.,        ft.Sand                     Gas                     Oil                     Total Depth 3256

## PRODUCTION

1st 24 hrs. Nat.                     1st 24 hrs. after shot                     Gas                      Cu. Ft.Dry Hole                     Abandoned                     

Date

MAY 15 1946

19

S. J. LEWIS

Scout