

Section 5 Township 16 Range 10WWell No. #6 HaskaCompany Magnolia

NORTH

SOUTH

WEST

EAST

14

0

Ellsworth **KANSAS**

Sec. 5 Twp. 16 R. 10W ☒

Well No. #6 Haska Farm

Magnolia Company

Contractor

Stoltenberg Pool


Ft. from N. Line

990' Ft. from S. Line

990' Ft. from E. Line

Ft. from W. Line

NW SE SW

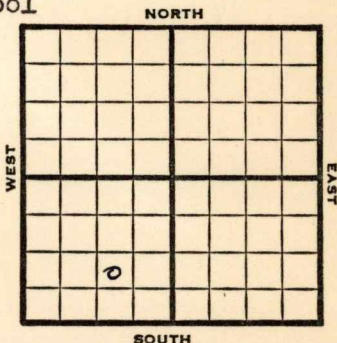

1951

Elev. 1790'

REPORT

1/24

Location

2/21

Spud 1-24-51

Oil well TD 3380

8" @408

Heeb. 2818 **Lans. 2921** **Arb. 3258-59**

5" @3259 TD 3272 500 A

S/ 3 gw 3 hr. DD 3279 B/ 1 goph

DD 3380 B/ 7 go 1 gwph 250 A

S/ 2 bo $1\frac{1}{2}$ bw 500 A S/ $\frac{1}{2}$ bo

14 bwph

Comp. 24 bopd 192 bw

COMPLETED

County **Ellsworth** State **Kansas**Sec. **5** (Blk. Twp.) **16** (Sur. Rge.) **10W** Map No.Operator **Magnolia**Well No. **6** Farm **Haska**Elev. Location **NW SE SW**

FIRST REPORT

0

990 Ft. From **S** Line **SW**990 Ft. From **E** Line Quarter1st. Report **JAN 24 1951**

Completion

Remarks

Spudding Date

Drlg. Data

Location

Stoltenberg Pool

J. E. TYRA

County Ellsworth State Kansas

Sec. 5 (Blk.) 16 (Sur.) 10W Map No.

Operator Magnolia

Well No. 6 Farm Haska

Elev.	1790	Location	NW SE SW
-------	------	----------	----------

COMPLETE

990 Ft. From S Line SW

990 Ft. From E Line Quarter

1st. Report

Completion FEB 21 1951

Remarks Stoltenberg Pool

Spudding Date 1-24-51

Drilg. Data Oil well TD 3380

8" @ 408 Heeb. 2818 Lans. 2921

Arb. 3258-59 5" @ 3259 TD 3272 500 A

S/ 3 gw 3 hr. DD 3279 B/ 1 goph

DD 3380 B/ 7 go 1 gwph 250 A

S 2 bo $1\frac{1}{2}$ bw 500 A S/ $\frac{1}{2}$ bo 14 bwph

Comp. 24 bopd 192 bw

J. E. TYRA