


Section 6 Township 16 Range 10W

Well No. #1 Barclay

Company R. J. Shields

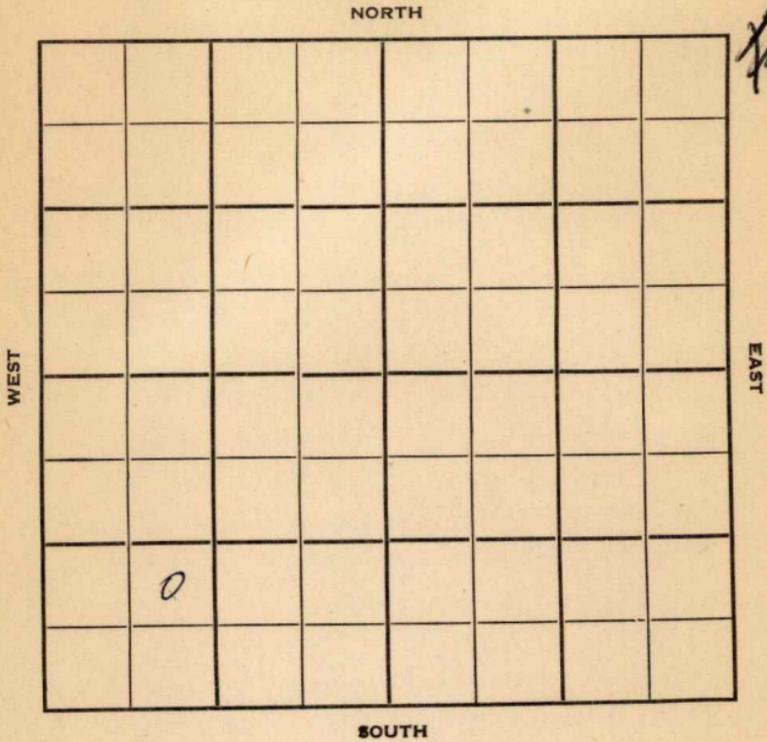

Ellsworth
16

KANSAS

Sec. 6 Twp. 16 R. 10W

Well No. #1 Barclay Farm

R. J. Shields Company

Stoltenberg Contractor


_____ Ft. from N. Line

990' Ft. from S. Line

_____ Ft. from E. Line

990' Ft. from W. Line

NE SW SW

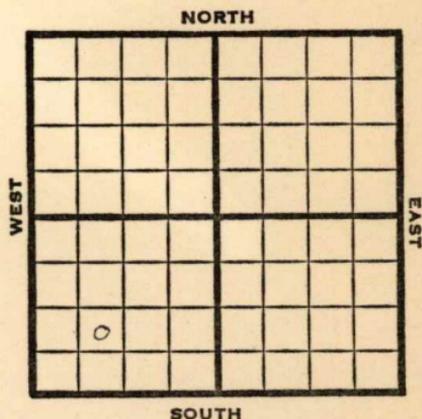

1950

Elev 1873'

REPORT

3/15

Location

5/3

TD 3353'

8"@ 209'

Heeb 2915'

Lans 3027'

Arb. 3342'

5"@ 3343'

10 BOPD / 48 BWPD

Comp

COMPLETED

Kansas

Stoltenberg

Map No. _____ Sec. 6 Twp. 16 R. 10W

Well No. 1 Barclay

R. J. Shields Company

Contractor

NE SW SW

SECTION PLAT

_____ Ft. from N. Line

990 Ft. from S. Line

_____ Ft. from E. Line

990 Ft. from W. Line

o			

FIRST REPORT

Ellsworth County

Location X

Rig up _____

Drilling and Remarks:

RECORD

Cased _____ in., _____ ft.

Sand _____

Gas _____

Oil _____

Total Depth _____

PRODUCTION

1st 24 hrs. Nat. _____

1st 24 hrs. after shot _____

Gas _____ Cu. Ft.

Dry Hole _____

Abandoned _____

Date

MAR 15 1950 19

J. E. TYRA Scout

Kansas

Stoltenberg Pool

Map No. _____ Sec. 6 Twp. 16 R. 10W

Well No. 1 Barclay

R. J. Shields Company

Contractor

NE SW SW

EI. 1873
SECTION PLAT

_____ Ft. from N. Line

990 Ft. from S. Line

_____ Ft. from E. Line

990 Ft. from W. Line

COMPLETE			
o			

Ellsworth County

Location _____

Rig up _____

Drilling and Remarks:

*8" @ 209
Feb 2915
Lans 3027
arb 3342
5" @ 3343
10 BOPD +
4 RWPD*

RECORD

Cased _____ in., _____ ft.

Sand _____

Gas _____

Oil _____

Total Depth 3353

PRODUCTION

1st 24 hrs. Nat. _____

1st 24 hrs. after shot _____

Gas _____ Cu. Ft.

Dry Hole _____

Abandoned _____

Date

MAY 3 1950

J. E. TYRA

19

Scout