


Russell KANSAS

Section 9 Township 15 Range 13-W

Well No. #7 Roesner

Company Stanolind

Coralena Pool

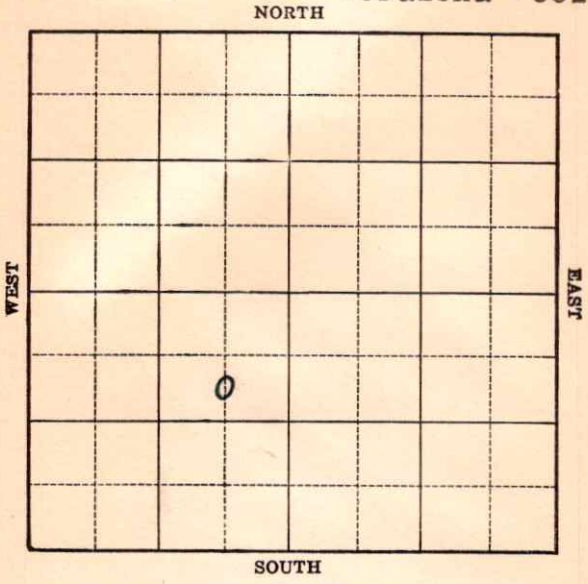

KANSAS


Russell

Sec. 9 Twp. 15 R. 13-WWell No. #7 Roesner FarmStanolind Company

(Coralena)

990 Ft. from N. Line Ft. from S. Line660 Ft. from E. Line Ft. from W. Line

Elev. 1847

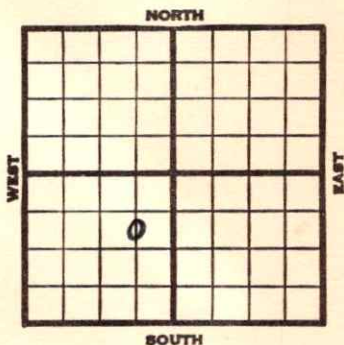

1940	REPORT
2/21	Location
2/29	Drlg. 650'
3/8	10" - 640' Anh. 808'
	Drlg. 1953'
3/14	Drlg. 2860'
3/21	Lans. 3017' S.O. 3037-77'
	Drlg. 3312'
3/28	Rework Arb. 3318' 7" - 3155'
	T.D. 3359' RUST.
4/4	Testing.
4/10	Arb. 3318'
	T.D. 3359'
	6000 acid.
	P.B. to 3058'
	Pump 1608 bbls.
	1/2 M gas.
	COMPLETED

Map No. 73 Sec. 9 Twp. 15 R. 13WWell No. 7 RoesnerStanolind

Company

Contractor

FIRST REPORT
C S L N E S W

SECTION PLAT

990 Ft. from N. Line

Ft. from S. Line

660 Ft. from E. Line

Ft. from W. Line

CORALENA POOL

Location X

Rig up

Drilling and Remarks:

RECORD

Cased _____ in., _____ ft.

Sand _____

Gas _____

Oil _____

Total Depth _____

PRODUCTION

1st 24 hrs. Nat. _____

1st 24 hrs. after shot _____

Gas _____ Cu. Ft.

Dry Hole _____

Abandoned _____

Date

FEB 21 1940 19S. J. LEWIS Scout

Map No. 73 Sec. 9 Twp. 15 R. 13WWell No. 7 Roesner

Stanolind

Company

Contractor

COMPLETED

C S L NE SW

990 Ft. from N. Line

Ft. from S. Line

660 Ft. from E. Line

Ft. from W. Line

CORALENA POOL

SECTION PLAT

Location _____

Rig up _____

Drilling and Remarks:

6000 acid
P.B. 3058

1608 lbs
pump.

1/2 m gas.

RECORD

Cased _____ in. _____ ft.

Sand Arbuckle 3318

Gas _____

Oil _____

Total Depth 3359

PRODUCTION

1st 24 hrs. Nat. _____

1st 24 hrs. after shot _____

Gas _____ Cu. Ft.

Dry Hole _____

Abandoned _____

Date

APR 10 1940 19

S. J. LEWIS

Scout