


Section 8 Township 16 Range 13W

Well No. #1 Bitter

Company Ogden Bros.

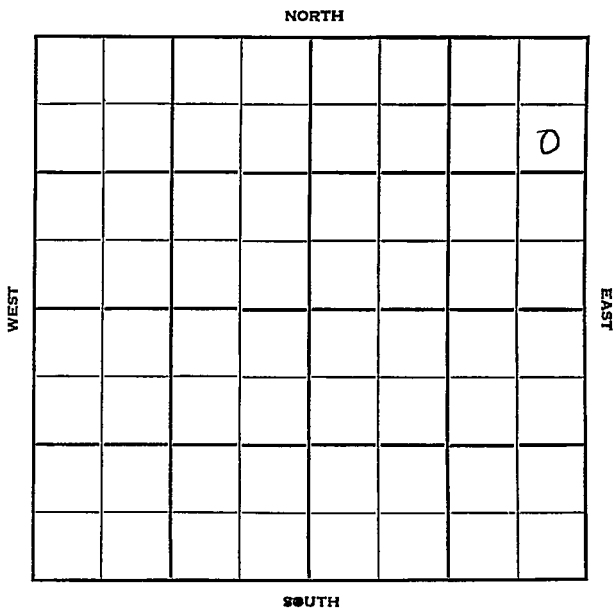

Barton

KANSAS

Sec. 8 Twp. 16 R. 13 W

Well No. # 1 Bitter Farm

Ogden Bros. Company

Murfin Drlg. Contractor

Trapp Pool


990 Ft. from N. Line

Ft. from S. Line

330 Ft. from E. Line

Ft. from W. Line

**SE NE NE
CSO Farmout**

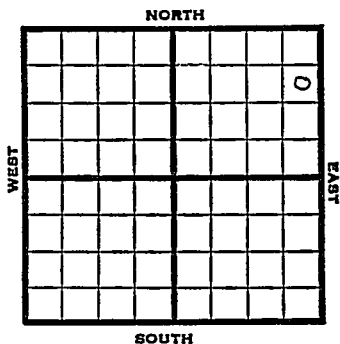

1951

Elev. 1935' REPORT

6/6 R U R

8/8 Spud 6-5-51
Oil Well TD 3398
8" @ 250
Anhy 885 Heeb 3069
Lans. 3147 Arb. 3389
TD 3395 5" @ 3389
DD 3397 500 A DD 3398
1000 A S/12-15 boph
Comp. 50 bopd

COMPLETED

County Barton State KansasSec. 8 (Blk.) 16 (Sur.) 13W Map No.Operator Ogden Bros.Well No. 1 Farm BitterElev. Location SE NE NE

							0

990 Ft. From N Line NE330 Ft. From E Line Quarter1st. Report JUN 6 1951

Completion

Remarks CSO farmoutMurfin Drlg. - Contr.

Spudding Date

Drlg. Data Trapp PoolR U R

J. F. TVRA

County Barton State Kansas
 Sec. 8 (Blk.) 16 (Sur.) 13W Map No.
 Operator Ogden Bros.
 Well No. 1 Farm Bitter
 Elev. 1935 Location SE NE NE

990 Ft. From N Line NE
330 Ft. From E Line Quarter
 1st. Report
 Completion AUG 8 1951
 Remarks Trapp Pool
Murfin Drlg. - Contr.
 Spudding Date 6-5-51

Drlg. Data Oil well TD 3398
8" @ 250 Anhy 885 Heeb. 3069
Lans. 3147 Arb. 3389 TD 3395
5" @ 3389 DD 3397 500 A DD 3398
1000 A S/ 12-15 boph Comp. 50 bopd