

KANSAS

Form 51—5M—7-39—Palace


Russell

Section 9 Township 15 Range 13-W

Well No. #8 Roesner

Company Stanolind

NORTH Coralena Pool

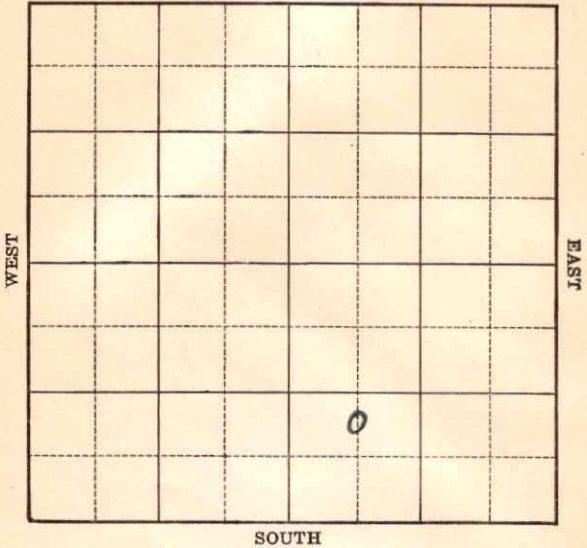

Map No. 73 Sec. 9 Twp. 15 R. 13WWell No. 8 Hoesner

Stanolind

Company

Contractor

FIRST REPORT

C N $\frac{1}{2}$ SW SE

Ft. from N. Line

990 Ft. from S. Line

Ft. from E. Line

660 Ft. from W. Line

CORALENA POOL

SECTION PLAT

Location X

Rig up

Drilling and Remarks:

RECORD

Cased _____ in., _____ ft.

Sand _____

Gas _____

Oil _____

Total Depth _____

PRODUCTION

1st 24 hrs. Nat. _____

1st 24 hrs. after shot _____

Gas _____ Cu. Ft.

Dry Hole _____

Abandoned _____

Date

MAR 20 1940 19

S. J. LEWIS

Scout

Map No. 73 Sec. 9 Twp. 15 R. 13WWell No. 8 RoesnerStanolind

Company

Contractor

COMPLETED

C $N\frac{1}{2}$ SW SE

SECTION PLAT

 Ft. from N. Line990 Ft. from S. Line Ft. from E. Line660 Ft. from W. Line

CORALENA POOL

Location Rig up

Drilling and Remarks:

*Lease. 2023**7" @ 3187**1000 acid**Pump 1566 Bx.*

RECORD

Cased in., ft.Sand Gas Oil Total Depth 3155

PRODUCTION

1st 24 hrs. Nat. 1st 24 hrs. after shot Gas Cu. Ft.Dry Hole Abandoned

Date

MAY 15 1940

19

S. J. LEWIS Scout

KANSAS

Russell

Sec. 9 Twp. 15 R. 13-WWell No. #8 Roesner FarmStanolind

Company

(Goralena)

Ft. from N. Line

990


Ft. from S. Line

Ft. from E. Line

660

Ft. from W. Line

Elev. 1848

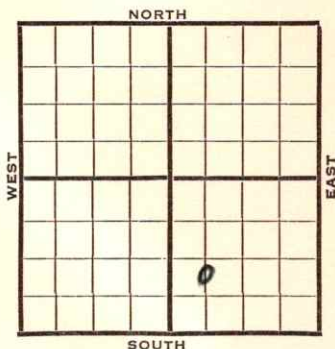

	REPORT
1940	
3/20	Location
3/28	"
4/4	10" - 630' WOC.
4/12	Anhy 795' Drlg. 2183'
4/18	Tarkio 2440' Coring 2911'
4/25	Dodge 2962' Lans. 3023'
	Pay 3039-63' Coring 3287'
5/2	7" - 3337' T.D. 3342'
5/9	" " " "
5/15	Lans. 3023'
	7" - 3137'
	T.D. 3155'
	1000 acid.
	Potential 1566 bbls., pump.
	COMPLETED