

KANSAS

FORM 51 5M 11-44 PETROL

Ellsworth county

Section 6 Township 16 Range 10W

Well No. #1, Weseley Barclay

Company Black-Marshall

NORTH

14

SOUTH

WEST

EAST

(Red circle mark in the 4th column, 8th row)

KANSAS

Sec. 6 Twp. 16 R. 10W

Well No. #1 Weseley Barclay Farm

Black-Marshall Company

Stotlenberg


 Ft. from N. Line

330 Ft. from S. Line

330 Ft. from E. Line

 Ft. from W. Line

SE SW

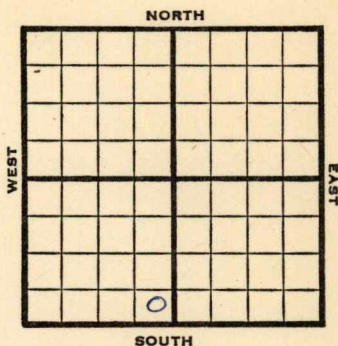

1946

Elev. 1848

REPORT

5/22 Location

5/29 "

6/5 8" @ 356' WOC

6/12 Anhy 655'
Drlg 2870'

6/18 Lans 3007
Arb 3327
TD 3330'
5" @ 3328 RUST

6/26 TD 3331-
5000 acid
Swb 65 oil in 5 hrs

7/3 " " "

7/10 Arb. 3327
5" @ 3328
500 acid.
TD 3331'
Pump 441 Pot.
Grav. 42.3

COMPLETED

KANSAS Kansas Pool Name Stoltenberg PoolMap No. 53 Sec. 6 Twp. 16 R. 10WWell No. 1 Weseley BarclayBlack-Marshall

Company

COMPLETED

Contractor

SE SW

E11845
SECTION PLAT Ft. from N. Line330 Ft. from S. Line330 Ft. from E. Line Ft. from W. Line

Ellsworth CountyLocation Rig up

Drilling and Remarks:

Cr. 33275" @ 3328500 acidPump 441 Pst.42 3/4**RECORD**Cased in., ft.Sand Gas Oil Total Depth 3331**PRODUCTION**1st 24 hrs. Nat. 1st 24 hrs. after shot Gas Cu. Ft.Dry Hole Abandoned

Date

JUL 10 1946

19

S. J. LEWIS

Scout

KANSASKansas Pool Name StotlenbergMap No. 55 Sec. 6 Twp. 16 10WWell No. 1 Weseley Barclay 1165/10MBlack-Marshall


Company

FIRST REPORT

Contractor

SE SW

SECTION PLAT

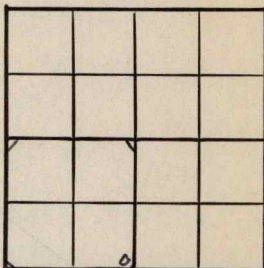

_____ Ft. from N. Line

330 Ft. from S. Line330 Ft. from E. Line

_____ Ft. from W. Line

Ellsworth County

RECORD

Location ✓

Cased _____ in., _____ ft.

Rig up _____

Sand _____

Drilling and Remarks:

Gas _____

Oil _____

Total Depth _____

PRODUCTION

1st 24 hrs. Nat. _____

1st 24 hrs. after shot _____

Gas _____ Cu. Ft.

Dry Hole _____

Abandoned _____

Date

MAY 22 1946

19

S. J. LEWIS

Scout