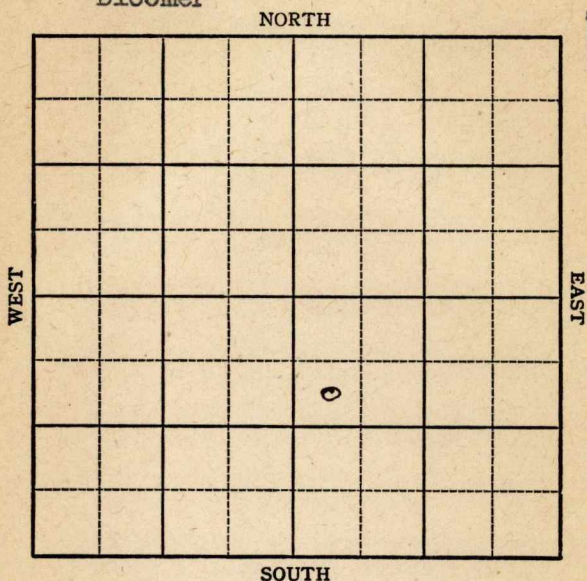


Ellsworth

KANSAS

Section 6 Township 16 Range 10WWell No. 1 Purma "A"Company Derby et al
Bloomer

KANSAS

Ellsworth

Sec. 6 Twp. 16 R. 10-W

Well No. #1 Purma "A" Farm


Derby etal Company
Bloomer Pool

990 Ft. from N. Line

 Ft. from S. Line

 Ft. from E. Line

330 Ft. from W. Line

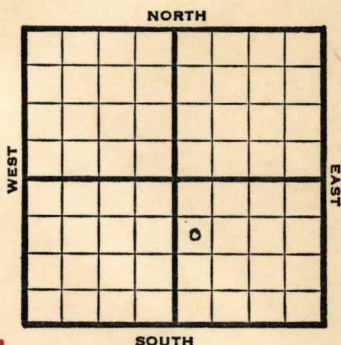

SW NW SE **Elev. 1857'**

REPORT

1947

3/19 Location

3/25 8" @ 397'
WOC

4/2 Drlg. 1775'.

4/9 **Lans 3019**
Arb 3356
TD 3368'

ABANDONED

Map No. 55 Sec. 6 Twp. 16 R. 10WWell No. 1 Purma "A"

Derby et al.


Company

FIRST REPORT

Contractor

SW NW SE

SECTION PLAT

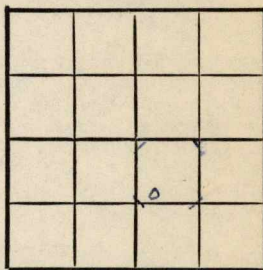990 Ft. from N. Line Ft. from S. Line Ft. from E. Line330 Ft. from W. LineEllsworth CountyLocation XRig up

Drilling and Remarks:

RECORD

Cased in., ft.Sand Gas Oil Total Depth

PRODUCTION

1st 24 hrs. Nat. 1st 24 hrs. after shot Gas Cu. Ft.Dry Hole Abandoned

Date

MAR 19 1947S. J. LEWIS Scout

Map No. 155 Sec. 6 Twp. 16 R. 10W

Well No. 1 Purma "A"

Derby et al. Company

ABANDONED

Contractor

SW NW SE


E. 1887
SECTION PLAT

990 Ft. from N. Line

 Ft. from S. Line

 Ft. from E. Line

330 Ft. from W. Line

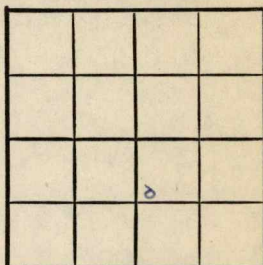

Ellsworth County

Location

Rig up

Drilling and Remarks:

Lans 3019

Per 3306

RECORD

Cased in., ft.

Sand

Gas

Oil

Total Depth 3365

PRODUCTION

1st 24 hrs. Nat.

1st 24 hrs. after shot

Gas Cu. Ft.

Dry Hole

Abandoned

Date

APR 9 1947 19

S. J. LEWIS

Scout