

KANSAS


Russell

FORM 51 5M 2-38 TPCO.

Section 9 Township 15 Range 13-W

Well No. 2 Rogg

Company R. H. Shields

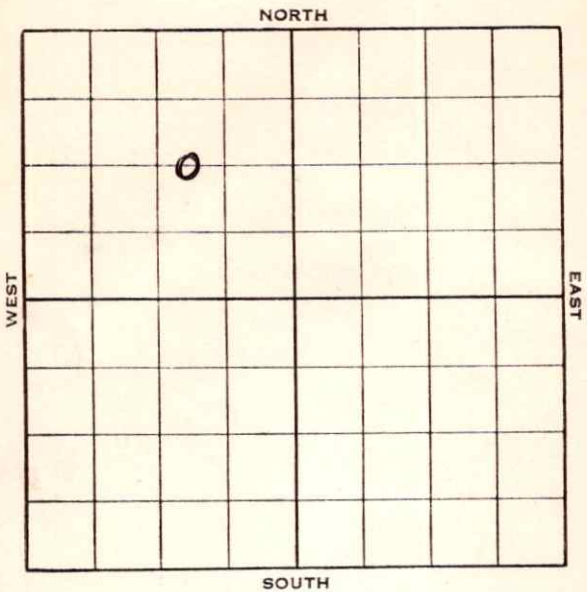

KANSAS


Russell

Sec. 9 Twp. 15 R. 13-WWell No. #2 Rogg FarmR. H. Shields Company1320 Ft. from N. Line

Ft. from S. Line

990 Ft. from E. Line

Ft. from W. Line

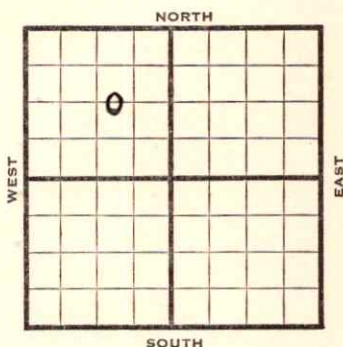

Elev. 1809'.

1938	REPORT
8/24	Location
9/2	"
9/9	Dldg. rig.
9/16	R.U.C.T.
9/23	"
9/30	12" - 380'. Dlg. 400'.
10/7	Anhy 754'. 10" - 767'.
	Dlg. 1185'.
10/14	Dlg. 1645'.
10/21	S. G. 2338-43'. 8" - 2343'.
	Inc. Gas 2358'. Topeka 2640'.
	S. O. 2845-50'. Dlg. 2865'.
10/28	Dodge 2924'. S.S.O. 2924-38'.
	Lans. 2972'. 6" - 2993'.
	Show gas 3000'. S.O. 3006-08'.
	WOC.
	OVER

1938

11/2

6" - 2993'.

Lans. 2972'.

T. D. 3020'.

20,000 acid.

Flow 686 bbls. 8 hrs.

Potential 2057 bbls.

S. S. W.

COMPLETED

Russell

KANSAS

Map No. 73 Sec. 9 Twp. 15 R. 13WWell No. 2 RoggR. H. Shields

Company

Contractor

FIRST REPORT

C W L $E\frac{1}{2}$ NW1320 Ft. from N. Line Ft. from S. Line990 Ft. from E. Line Ft. from W. Line

SECTION PLAT

	0		

Location XRig up

Drilling and Remarks:

RECORD

Cased in., ft.Sand Gas Oil Total Depth

PRODUCTION

1st 24 hrs. Nat. 1st 24 hrs. after shot Gas Cu. Ft.Dry Hole Abandoned

Date

AUG 24 1938

19

H. D. Hatfield

Scout

Map No. 72 Sec. 9 Twp. 15 R. 13WWell No. 2 RoggR. H. Shields

Company

Contractor

COMPLETED

C W L $E\frac{1}{2}$ NW1320 Ft. from N. Line

Ft. from S. Line

990 Ft. from E. Line

Ft. from W. Line

SECTION PLAT

	0		

Location

RECORD

Cased 6 in., 2993 ft.Sand LANS 2972

Gas

Oil

Total Depth 3020

PRODUCTION

1st 24 hrs. Nat.

1st 24 hrs. after shot

Gas Cu. Ft.

Dry Hole

Abandoned

Rig up

Drilling and Remarks:

20,000 acidFlow 686/8 hrsPOT 2057S.S.W.

Date

NOV 2 - 1938 19

H. D. Hatfield

Scout