

# KANSAS

FORM 51 25M 3-49 PETROL

Ellsworth

Section 6 Township 16 Range 10-W

Well No. #1 Rezac

Company Shields Oil

NORTH

|  |  |  |  |  |  |   |  |
|--|--|--|--|--|--|---|--|
|  |  |  |  |  |  |   |  |
|  |  |  |  |  |  |   |  |
|  |  |  |  |  |  | 8 |  |
|  |  |  |  |  |  |   |  |
|  |  |  |  |  |  |   |  |
|  |  |  |  |  |  |   |  |
|  |  |  |  |  |  |   |  |
|  |  |  |  |  |  |   |  |

SOUTH

WEST

EAST

Ellsworth

KANSAS

Sec. 6 Twp. 16 R. 10W

Well No. #1 Rezac Farm

Shields Oil

Company

Contractor

Wildcat

Ft. from N. Line

990'

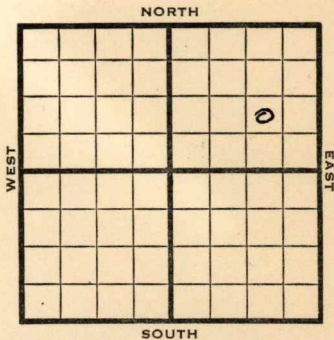
Ft. from S. Line

990'

Ft. from E. Line

Ft. from W. Line

NW SE NE



1950

Elev 1862

REPORT

8/9

Location

9/13

Spud 8-12-50

8" @ 325

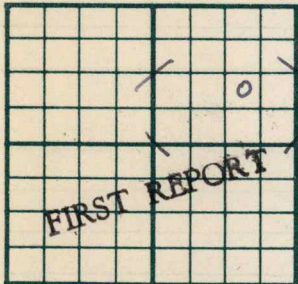
Anhy 660

Arb 3389-90 TD

TD 3390

D&A

ABANDONED

County Ellsworth State KansasSec. 6 (Blk.) 16 (Sur.) LOW Map No.Operator Shields OilWell No. 1 Farm RezacElev. Location NW SE NE990 Ft. From S Line NE990 Ft. From E Line Quarter1st. Report AUG 9 1950

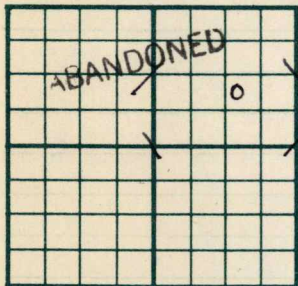
Completion

Remarks

Spudding Date

Drlg. Data WildcatLocation

J. E. TYRA

County Ellsworth State KansasSec. 6 (Blk.  
Twp.) 16 (Sur.  
Rge.) 10W Map No.Operator Shields OilWell No. 1 Farm RezacElev. 1862 Location NW SE NE990 Ft. From S Line NE990 Ft. From E Line Quarter

1st. Report

Completion SEP 13 1950

Remarks

WildcatSpudding Date 8-12-50Drlg. Data D & A TD 33908" @ 325 Anhy 660 Arb. 3389-90 TDD & A

J. E. TYRA