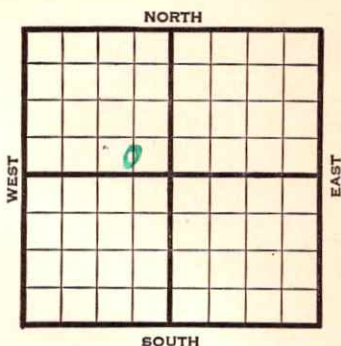


Company R. H. Shields


Sec. 9 Twp. 15 R. 13-WWell No. #4 Rogg FarmR. H. Shields Company

(Coralena)

 Ft. from N. Line330 Ft. from S. Line660 Ft. from E. Line Ft. from W. Line

Elev. 1817

1940	REPORT
9/4	Cable.
9/12	20" - 24' 12" - 421'
	Drlg. 760'
9/19	Anhy 760' 10" - 775'
	Drlg. 1755'
9/26	8" - 2400'
	TD 2453' SD.
10/3	" "
10/10	Lans. 2989' 7" - 2993'
	T.D. 3043' 1800' oil.
	5000 acid. Testing.
10/16	Lans. 2989'
	7" - 2993'
	T.D. 3043'
	5000 acid.
	Potential 2281 bbls., pump.
	COMPLETED

Map No. _____ Sec. 9 Twp. 15 R. 13WWell No. 4 RoggR. H. Shields

Company _____

Contractor _____

FIRST REPORT

C S L SE NW

_____ Ft. from N. Line

330 Ft. from S. Line660 Ft. from E. Line

_____ Ft. from W. Line

CORALENA POOL

SECTION PLAT

Location _____

Rig up _____

Drilling and Remarks:

Cable

RECORD

Cased _____ in., _____ ft.

Sand _____

Gas _____

Oil _____

Total Depth _____

PRODUCTION

1st 24 hrs. Nat. _____

1st 24 hrs. after shot _____

Gas _____ Cu. Ft.

Dry Hole _____

Abandoned _____

Date

SEP 4 1940 19S. J. LEWIS Scout

Map No. 73 Sec. 9 Twp. 15 R. 13WWell No. 4 RoggR. H. Shields

Company

Contractor

COMPLETED

C S L SE NW

SECTION PLAT

 Ft. from N. Line330 Ft. from S. Line660 Ft. from E. Line Ft. from W. Line

CORALENA POOL

Location Rig up

Drilling and Remarks:

Lane 28887" @ 28935000 acidPump 2281 BX.

RECORD

Cased in., ft.Sand Gas Oil Total Depth 2043

PRODUCTION

1st 24 hrs. Nat. 1st 24 hrs. after shot Gas Cu. Ft.Dry Hole Abandoned

Date

OCT 16 1940 19S. J. LEWIS Scout