


Section 6 Township 16 Range 10W
 Well No. #1 Rezac
 Company Ferrell Drlg.

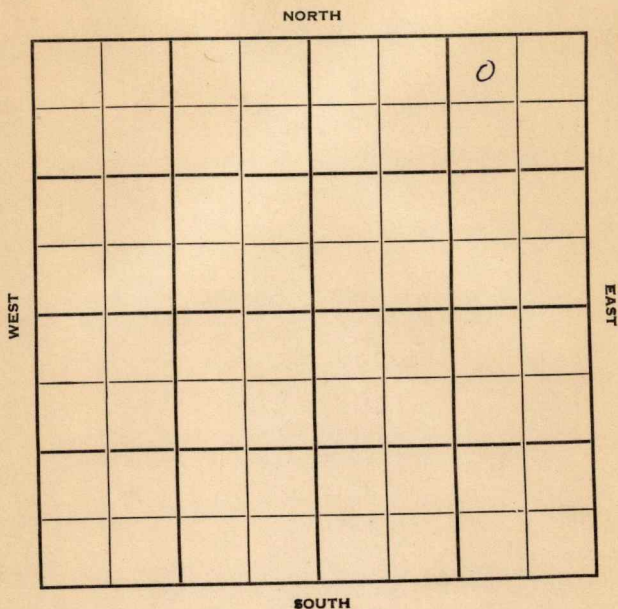

Sec. 6 Twp. 16 R. 10W

Well No. #1 Rezac Farm

Ferrell Drlg. Company

Stoltenberg Pool Contractor


330' Ft. from N. Line

 Ft. from S. Line

990' Ft. from E. Line

 Ft. from W. Line

NW NE NE

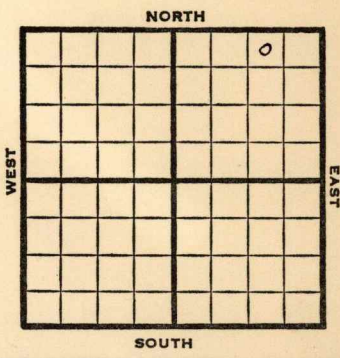

1950 Elev. 1854' REPORT

4/12 8-5/8" @ 352'
Anhy 670'
Lans. 2991'
Drlg. 3023'

5/3 TD 3338'
8 5/8" @ 352'
Lans 2991'
Arb. 3327'
5" @ 3329'
25 BOPD
Comp

COMPLETED

Kansas

Stoltenberg Pool

Map No. _____ Sec. 6 Twp. 16 R. 10WWell No. 1 Rezac

Ferrell Drlg.

Company

Contractor

NW NE NE

SECTION PLAT

330 Ft. from N. Line

_____ Ft. from S. Line

990 Ft. from E. Line

_____ Ft. from W. Line

Ellsworth County

			0
COMPLETE			

Location _____

Rig up _____

Drilling and Remarks:

8 5/8" @ 352Land 2991Ant 33275" @ 332925 BOPD

RECORD

Cased _____ in., _____ ft.

Sand _____

Gas _____

Oil _____

Total Depth 3338

PRODUCTION

1st 24 hrs. Nat. _____

1st 24 hrs. after shot _____

Gas _____ Cu. Ft.

Dry Hole _____

Abandoned _____

Date

MAY 3 1950

19

J. E. TVDA

Scout

Kansas

Stoltenberg Pool

Map No. _____ Sec. 6 Twp. 16 R. 10WWell No. 1 Rezac_____
Ferrell Drlg. _____ Company_____
Contractor

NW NE NE

E1. 1854

SECTION PLAT

330

Ft. from N. Line

Ft. from S. Line

990

Ft. from E. Line

Ft. from W. Line

Ellsworth County



Location _____

Rig up _____

Drilling and Remarks:

8 5/8" @ 352

Anhy 670-70

Lans. 2991

drlg. 3023

RECORD

Cased _____ in., _____ ft.

Sand _____

Gas _____

Oil _____

Total Depth _____

PRODUCTION

1st 24 hrs. Nat. _____

1st 24 hrs. after shot _____

Gas _____ Cu. Ft.

Dry Hole _____

Abandoned _____

Date

APR 12 1950 19

J. E. TYRA

Scout