

KANSAS


Ellsworth

Form 51-5M-7-39-Palace

Section 6 Township 16 Range 10W

Well No. #1 Sebasta

Company Wentz et al

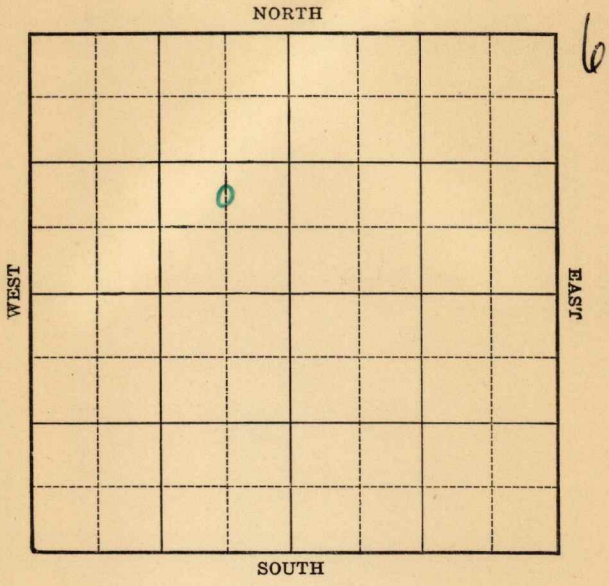

Sec. 6 Twp. 16 R. 10-W

Well No. #1 Sebasta Farm

Wentz et al Company

(Stoltenberg)


\_\_\_\_\_ Ft. from N. Line

990 Ft. from S. Line

660 Ft. from E. Line

\_\_\_\_\_ Ft. from W. Line

**Elev. 1829**

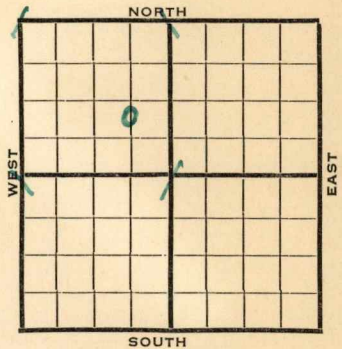

1940	REPORT
7/17	Location
7/25	<b>Anhy. 646' 8" - 663'</b> Drlg. 1330'
8/2	<b>Topeka 2630'</b> Drlg. 2926'
8/7	<b>Arb. 3355'</b> T.D. 3366' No shows.
	<b>ABANDONED</b>

Map No. \_\_\_\_\_ Sec. 6 Twp. 16 R. 10W

Well No. 1 Sebast

Wentz etal Company

FIRST REPORT Contractor

C N L SE NW

\_\_\_\_\_ Ft. from N. Line

990 Ft. from S. Line

660 Ft. from E. Line

\_\_\_\_\_ Ft. from W. Line

STOLTENBERG POOL

**SECTION PLAT**


Location X

Rig up \_\_\_\_\_

Drilling and Remarks:

**RECORD**

Cased \_\_\_\_\_ in., \_\_\_\_\_ ft.

Sand \_\_\_\_\_

Gas \_\_\_\_\_

Oil \_\_\_\_\_

Total Depth \_\_\_\_\_

**PRODUCTION**

1st 24 hrs. Nat. \_\_\_\_\_

1st 24 hrs. after shot \_\_\_\_\_

Gas \_\_\_\_\_ Cu. Ft.

Dry Hole \_\_\_\_\_

Abandoned \_\_\_\_\_

Date

JUL 17 1940

19

S. J. LEWIS Scout

Map No. 55 Sec. 6 Twp. 16 R. 10W

Well No. 1 Sebasta

Wentz etal Company

Contractor

ABANDONED

SECTION PLAT

C N L SE NW

	o		

\_\_\_\_\_ Ft. from N. Line

990 Ft. from S. Line

660 Ft. from E. Line

\_\_\_\_\_ Ft. from W. Line

STOLTENBERG POOL

Location \_\_\_\_\_

Rig up \_\_\_\_\_

Drilling and Remarks:

*Cr & 3355*  
*No show*

RECORD

Cased \_\_\_\_\_ in., \_\_\_\_\_ ft.

Sand \_\_\_\_\_

Gas \_\_\_\_\_

Oil \_\_\_\_\_

Total Depth 3366

PRODUCTION

1st 24 hrs. Nat. \_\_\_\_\_

1st 24 hrs. after shot \_\_\_\_\_

Gas \_\_\_\_\_ Cu. Ft.

Dry Hole \_\_\_\_\_

Abandoned \_\_\_\_\_

Date

AUG 7 1940 19

S. J. LEWIS Scout