


KANSAS

Ellsworth County

Section 6 Township 16 Range 10-W

Well No. #2, Barclay

Company Black-Marshall

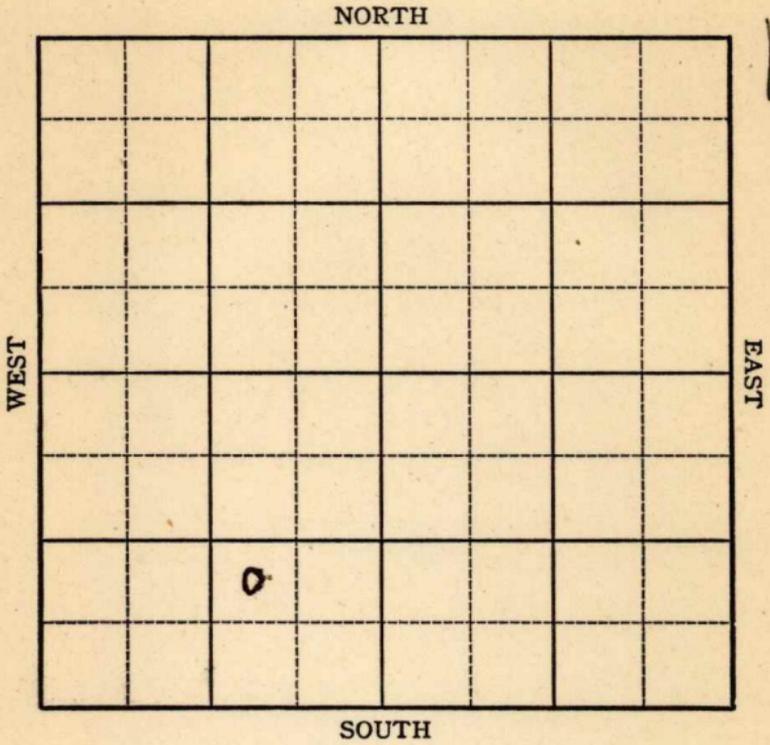

KANSAS

Ellsworth county ✓

Sec. 16 6 Twp. 16 R. 10-W

Well No. #2, Barclay Farm _____

Black-Marshall Company

Bloomer


_____ Ft. from N. Line

990' Ft. from S. Line

990' Ft. from E. Line

_____ Ft. from W. Line

NW SE SW

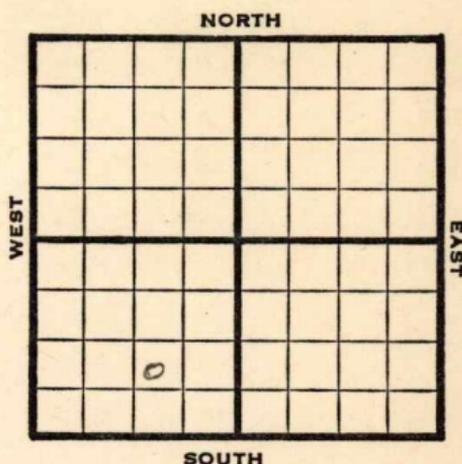

1946

1868

REPORT

- 10/2 Location.
- 10/15 "
- 10/22 "
- 10/29 "
- 11/7 8" @ 360'
Anhy 680'
Lans 3024
Arb 3342-45 TD
- 11/12 5" @ 3343, RUST
- 11/20 " "
- 11/27 TD 3 350'
- 12/4 Arb 3342'
5" @ 3343'
TD 3350'
1000 Acid
Pump 25 POT
42 Grav.

COMPLETED

KANSAS Kansas Pool Name Bloomer
 Map No. 55 Sec. 6 Twp. 16 R. 10W

Well No. 2 Barclay

Black-Marshall Company

CORRECTION Contractor

NW SE SW

SECTION PLAT

	0		

_____ Ft. from N. Line
990 Ft. from S. Line
990 Ft. from E. Line
 _____ Ft. from W. Line

Ellsworth County

RECORD

Location _____

Rig up _____

Drilling and Remarks:

Reported

16-16-10W

Cased _____ in., _____ ft.

Sand _____

Gas _____

Oil _____

Total Depth _____

PRODUCTION

1st 24 hrs. Nat. _____

1st 24 hrs. after shot _____

Gas _____ Cu. Ft.

Dry Hole _____

Abandoned _____

Date

OCT 2 1946 19

S. J. LEWIS Scout

