

Section 32 Township 16 Range 8W

Well No. 1 Hodgson "A"

Company Continental Oil

A blank 8x8 grid with directional labels: NORTH (top), SOUTH (bottom), WEST (left), and EAST (right). The grid is used for plotting a path. A handwritten '16' is in the top right corner, and a handwritten '0' is in the bottom right corner.

Ellsworth

KANSAS ✓


Sec. 32 Twp. 16 R. 8WWell No. 1 Hodgson "A" FarmContinental Oil CompanyLohman & Johnson - Contr. ContractorAndrews Pool

Ft. from N. Line

330 Ft. from S. Line405 Ft. from E. Line

Ft. from W. Line

SE SE SE

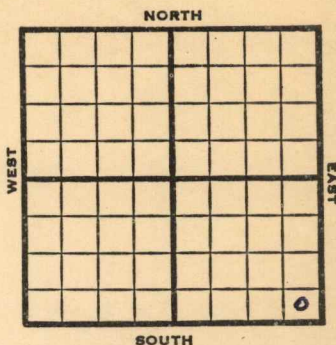

1953

Elev. 1690'

REPORT

4/1

R U R

4/9

10" @ 326

Drlg. 2928'

4/16

Br Li 2736, Lans 2756, BKC 3102,
V 3156, Simp 3201, Arb 3248

RTD 3273

5" @ 3250

4/23

DD 3283' TD

S/68 BO 2 hrs 1000' OB

4/30

NR

5/7

"

5/20

spud 4-1-53

Oil Well

TD 3283

10" @ 326

Br lime 2736, Lans 2756, B KC 3102,
Viola 3156, Simp 3201, Arb 3248

TD 3273

5" @ 3250,

DD 3283

S/68 bo 2 hrs.

Comp. 474 bopd

COMPLETED

County Ellsworth State KansasSec. 32 (Blk. 16 (Sur. 8W Map No.)
(Twp.) (Rge.)Operator Continental OilWell No. 1 Farm Hodgson "A"Elev. Location SE SE SE330 Ft. From S Line SE405 Ft. From E Line Quarter1st. Report APR 1 1953Completion Remarks Lehman & Johnson - ContrSpudding Date Drlg. Data Andrews PoolR U R

J. G. McGEHEE

County Ellsworth State Kansas

Sec. 32 (Blk.) 16 (Sur.) 8W Map No.

Operator Continental Oil

Well No. 1 Farm Hodgson "A"

Elev. 1690 Location SE SE SE



330 Ft. From S Line SE

405 Ft. From E Line Quarter

1st. Report

Completion MAY 20 1953

Remarks Andrews Pool

Lohman & Johnson - Contr.

Spudding Date 4-1-53

Drilg. Data Oil well TD 3283

10" @ 326 Br. lime 2736 Lans. 2756

B KC 3102 Viola 3156 Simp. 3201

Arb. 3248 TD 3273 5" @ 3250 DD 3283

S/ 68 bo 2 hr. Comp. 474' bopd

J. G. McGINTEE