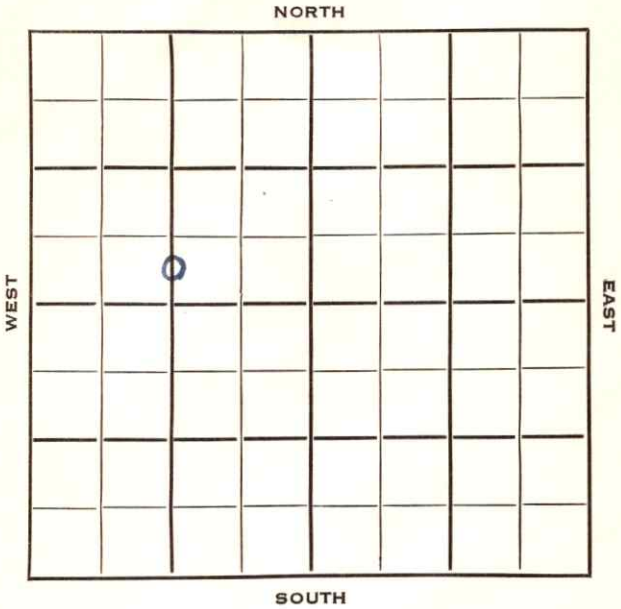


Section 9 Township 15 Range 13 W

Well No. # 9 Rogg "A"

Company Shields Oil Producers



Russell

KANSAS

SEC.	TWP.	R.
9	15	13 W

WELL NO.

9 Rogg "A"

FARM

COMPANY

Shields Oil Producers

CONTRACTOR

Shields Prod.

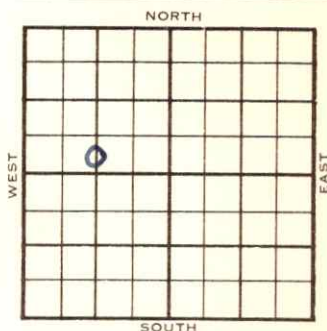
Trapp Pool

Ft. from N. Line

330 Ft. from S. Line

Ft. from E. Line

1320 Ft. from W. Line

C S $\frac{1}{2}$ S $\frac{1}{2}$ NW

1953

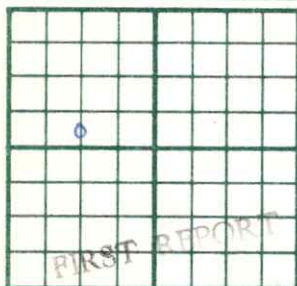
ELEVATION
1863'

REPORT

11/24 Spud 11-23-53
 12/9 10" @ 825'
 Drlg. 1840'
 12/16 Tarkio 2398'
 7" @ 2398'

12/30 Spud 11-23-53
 Oil Well
 TD 2407'
 Anhy 817'
 10" @ 825'
 Tarkio 2398'
 7" @ 2398'
 TD 2407'
 CO to 2404'
 frac S/ wtr. & oil 1 mcfg P/ 2 bo
 2 bwpd
 Comp 2 bopd 2 bw. 100,000 cfg.

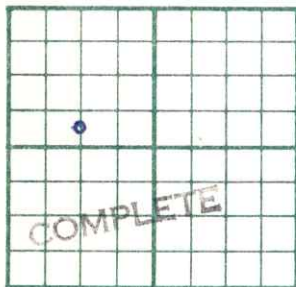
COMPLETED

County Russell State KansasSec. 9 (Blk.) 15 (Sur.) 13W Map No.Operator Shields Oil ProducersWell No. 9 Farm Rogg "A"Elev. Location C S $\frac{1}{2}$ S $\frac{1}{2}$ NW330 Ft. From S Line NW1320 Ft. From W Line Quarter1st. Report NOV 24 1953

Completion

Remarks

Shield Prod. - Contr.Spudding Date 11-23-53Drlg. Data Trapp Pool

County Russell State KansasSec. 9 (Blk. 15 (Sur. 13W Map No.)
(Twp.) (Rge.)Operator Shields Oil ProducersWell No. 9 Farm Rogg "A"Elev. 1863 Location C S $\frac{1}{2}$ S $\frac{1}{2}$ NW330 Ft. From S Line NW1320 Ft. From W Line Quarter

1st. Report

DEC 30 1953

Completion

Remarks Trapp PoolShields - Contr.Spudding Date 11-23-53Drlg. Data Oil well TD 2407Anhy 817 10" @ 825 Tarkio 23987" @ 2398 TD 2407 OO to 2404 fracS/ wtr. & oil 1 mcfg P/ 2 bo 2 bwpdComp. 2 bopd 2 bw 100,000 cfg