


Section 32 Township 16 Range 8W

Well No. #2 E. H. Hodgson "A"

Company Continental Oil

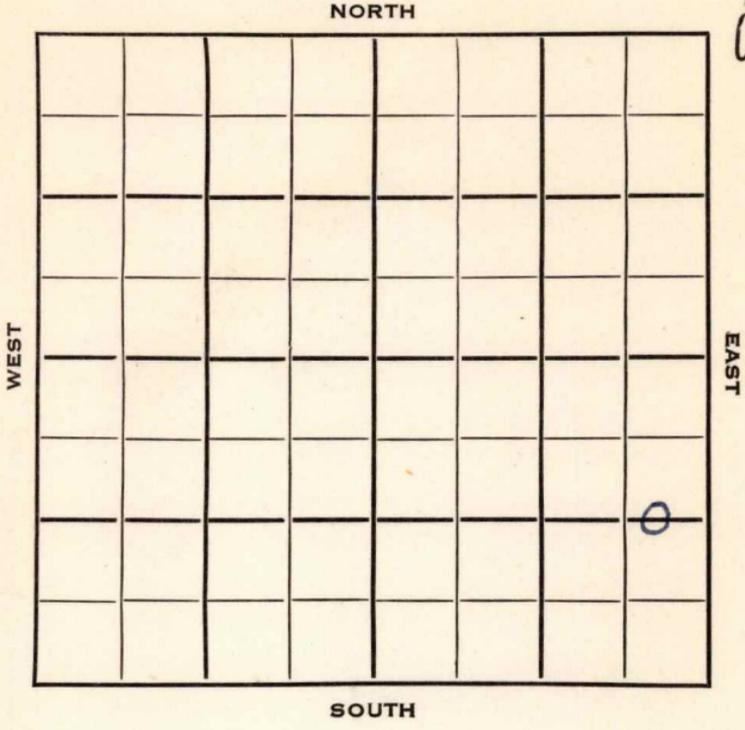

Sec. 32 Twp. 16 R. 8 W

Well No. # 2 E. H. Hodgson "A" Farm

Continental Oil Company

Garvie Contractor

**Andrews Pool**


         Ft. from N. Line

1320 Ft. from S. Line

490 Ft. from E. Line

         Ft. from W. Line

C E $\frac{1}{2}$  E $\frac{1}{2}$  SE

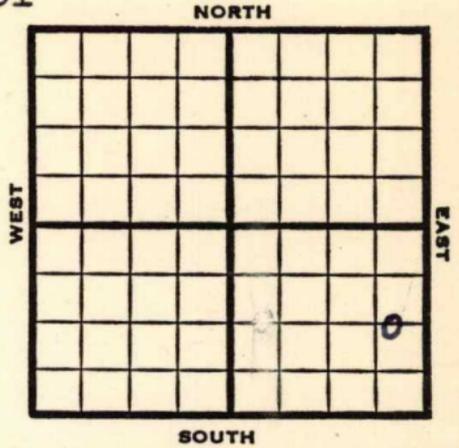

1953

**Elev. 1665'** REPORT

5/6

Spud 4-29-53  
10" @ 296  
Drlg. 2840'

5/21

NR

5/28

"

6/10

Spud 4-29-53  
Oil Well  
TD 3335'  
10" @ 296'  
**Br. Lime 2711, Lans 2733, Cong 3102, Maq. 3118, Viola 3165, Simp 3212, Arb 3284,**  
DS 3282-88 opn 1 hr, rec 60' free oil, 40' ho & gcm, 60' sul. wtr.  
1040#  
TD 3335'  
5" @ 3333'  
CO to TD 18/ 3283-86 DB/ 2 go 3 gw  
1 hr. 7/ 3286-87 100 A 250 A FU  
1275' fluid 4 hr.  
S/ 8 bo 16 bw 4 hr.  
Comp. 55 bopd 79% wtr.

**COMPLETED**




County Ellsworth State Kansas

Sec. 32 (Blk. Twp.) 16 (Sur. Rge.) 8W Map No.

Operator Continental Oil

Well No. 2 Farm E. H. Hodgson "A"

Elev. 1665 Location C E  $\frac{1}{2}$  E  $\frac{1}{2}$  SE

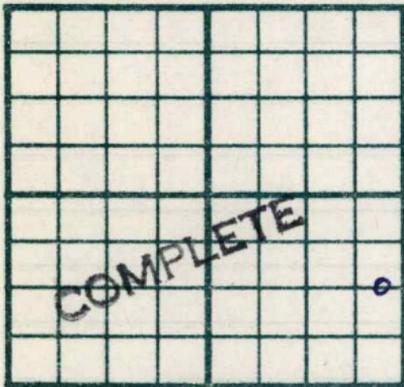

1320 Ft. From S Line SE

490 Ft. From E Line Quarter

1st. Report

Completion JUN 10 1953

Remarks Andrews Pool

Garvie - Contr.

Spudding Date 4-29-53

Drlg. Data Oil well TD 3335

10" @ 296 Br. lime 2711 Lans. 2733

Cong. 3102 Mag. 3118 Viola 3165

Simp. 3212 Arb. 3284 DST 3282-88

open 1 hr. Rec. 60' free oil 40' ho &

gcm 60' sul. wtr. 1040# TD 3335

5" @ 3333 CO to TD 18/ 3283-86

B/ 2 go 3 gw 1 hr. 7/ 3286-87

100 A 250 A FU 1275' fluid 4 hr.

S/ 8 bo 16 bw 4 hr.

Comp. 55 bopd 79% wtr.