

KANSAS


Russell

FORM 51 5M 4-41 PETROL

Section 9 Township 15 Range 13W

Well No. 6-Rogg

Company R. H. Shields

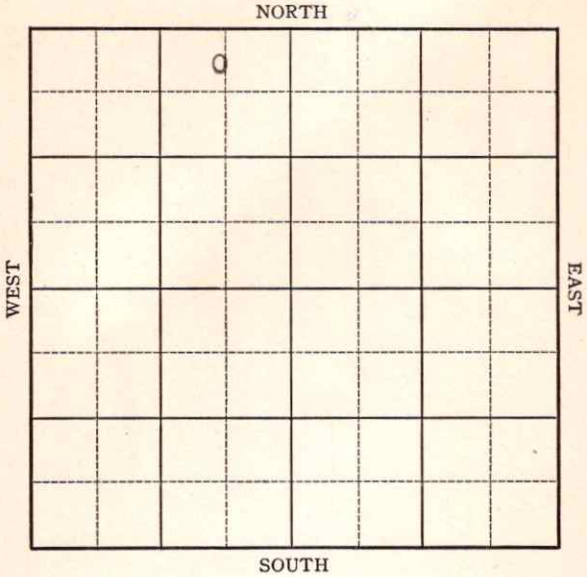

1941
12/10

Lans. 2945'

7" - 2946'

T.D. 2991'

5000 acid.

Potential 353 bbls., pump.

39. Gravity

COMPLETED

Map No. _____ Sec. 9 Twp. 15 R. 13WWell No. 6 RoggR. H. Shields Company

Contractor

FIRST REPORT

SECTION PLAT

C NL NE NW

330 Ft. from N. Line

_____ Ft. from S. Line

660 Ft. from E. Line

_____ Ft. from W. Line

	o		

HALL-GURNEY POOL

Location X

Rig up _____

Drilling and Remarks:

RECORD

Cased _____ in., _____ ft.

Sand _____

Gas _____

Oil _____

Total Depth _____

PRODUCTION

1st 24 hrs. Nat. _____

1st 24 hrs. after shot _____

Gas _____ Cu. Ft.

Dry Hole _____

Abandoned _____

Date

SEP 10 1941 19S. J. LEWIS Scout

Map No. 93 Sec. 9 Twp. 15 R. 13W

Well No. 6 Rogg

R. H. Shields Company

COMPLETED

Contractor

C NL NE NW


330 Ft. from N. Line

_____ Ft. from S. Line

660 Ft. from E. Line

_____ Ft. from W. Line

SECTION PLAT

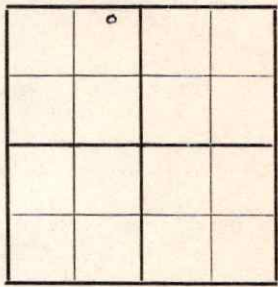

HALL GURNEY POOL

Location _____

Rig up _____

Drilling and Remarks:

*Lans 2945
 7" C 2946
 5000 acid
 Pump 353 P & J
 39° W*

RECORD

Cased _____ in., _____ ft.

Sand _____

Gas _____

Oil _____

Total Depth 2991

PRODUCTION

1st 24 hrs. Nat. _____

1st 24 hrs. after shot _____

Gas _____ Cu. Ft.

Dry Hole _____

Abandoned _____

Date

DEC 10 1941 19

S. J. LEWIS Scout