


KANSAS

Section 6 Township 16 Range 10W

Well No. #2 Barkley

Company Shields & Anschutz

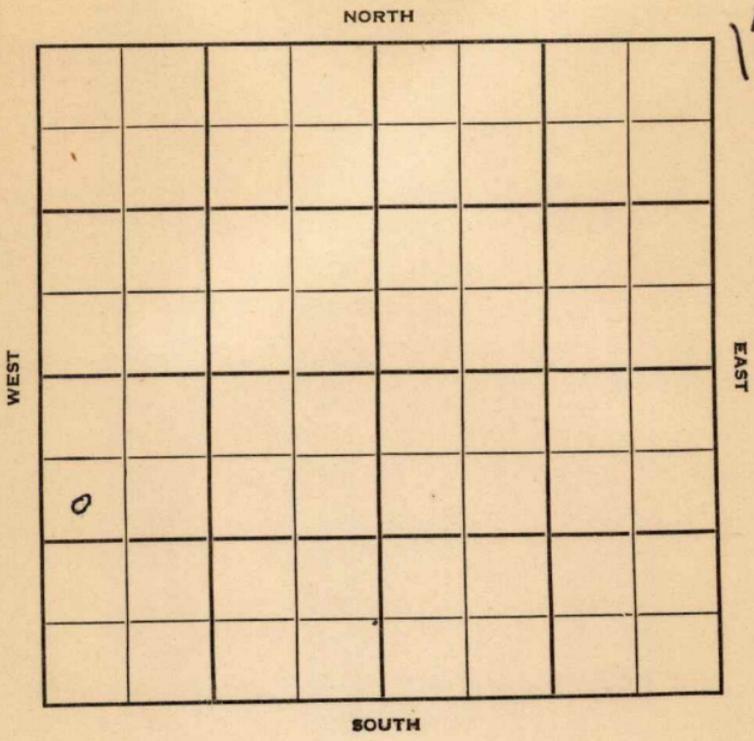

Ellsworth

KANSAS
10W ✓

Sec. 6 Twp. 16 R. 10W

Well No. #2 Barkley Farm

Shields & Anschutz Company

Contractor


990' Ft. from N. Line

_____ Ft. from S. Line

_____ Ft. from E. Line

330' Ft. from W. Line

SW NW SW

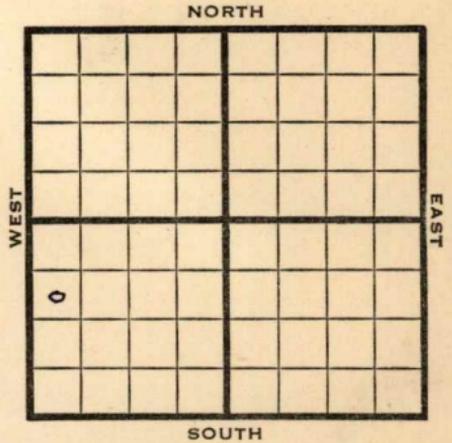

1950

Elev 1865'

REPORT

4/26 Rig up

5/24 8 5/8" @ 350

Arb 3357-63

5" @ 3360

TD 3363

250 acid

Comp 25 BOPD

Completed

COMPLETED

ansatz

Map No. _____ Sec. 6 Twp. 16 R. 10W

Well No. 2 Barkley

Shields & Anschutz Company

Contractor

SW NW SW

990

Ft. from N. Line

Ft. from S. Line

Ft. from E. Line

330

Ft. from W. Line

Ellsworth County

SECTION PLAT



RECORD

Location _____

Cased _____ in., _____ ft.

Rig up X

Sand _____

Drilling and Remarks:

Gas _____

Oil _____

Total Depth _____

PRODUCTION

1st 24 hrs. Nat. _____

1st 24 hrs. after shot _____

Gas _____ Cu. Ft.

Dry Hole _____

Abandoned _____

Date

APR 26 1950 19

J. E. TYRA Scout

Kansas

Map No. _____ Sec. 6 Twp. 16 R. 10W

Well No. 2 Barkley

Shields & Anschutz Company

Contractor

SW NW SW

E1.1865

SECTION PLAT

990 Ft. from N. Line

_____ Ft. from S. Line

_____ Ft. from E. Line

330 Ft. from W. Line

	COMPLETE			
0				

Ellsworth

Location _____

Rig up _____

Drilling and Remarks:

8 5/8" c 350
 arb. 3357-63
 5" c 3360
 T.D. 3363
 250 acid
 Comp. 25 bopd

RECORD

Cased _____ in., _____ ft.

Sand _____

Gas _____

Oil _____

Total Depth _____

PRODUCTION

1st 24 hrs. Nat. _____

1st 24 hrs. after shot _____

Gas _____ Cu. Ft.

Dry Hole _____

Abandoned _____

Date

MAY 24 1950 19

J. E. TYRA Scout