


Ellsworth

KANSAS

SECTION 6 TOWNSHIP 16 RANGE 10W

WELL NO. #2 Razeo

COMPANY Bennett & Roberts

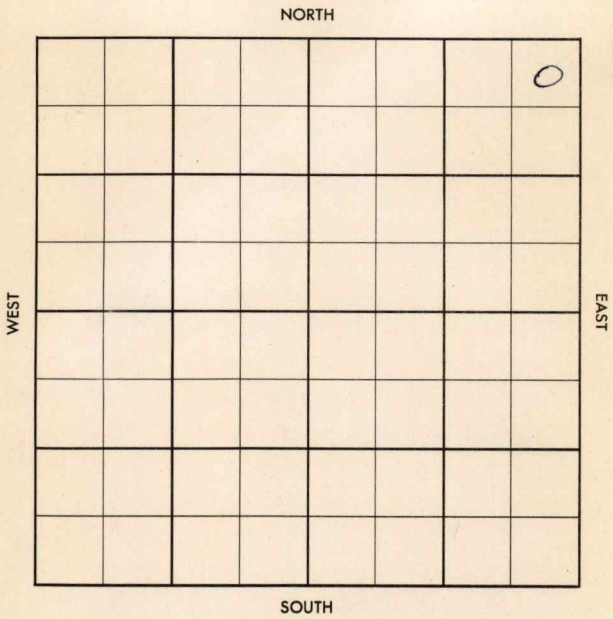

County Ellsworth Elev. 1836
 Sec. 6 Twp. 16S Rge. 10W
 Company Bennett & Roberts
 Farm Name Vazec No. 2

TOPS	DEPTH	LOG	DATUM
Anb.		<i>corrected</i>	
TP.			
H.	<u>2889</u>	<u>2877</u>	
Tr. <i>Bridge</i>	<u>2914</u>	<u>2902</u>	
Dg.		<u>2915</u>	
BL.	<u>2990</u>	<u>2978</u>	
L.	<u>3070</u>	<u>2998</u>	
K.C.			
B.K.C.			
Ce.			
C.	<u>3293</u>	<u>3281</u>	
M.			
M.			
K.			
Mz.			
Me.			
V.			
S.	<u>3315</u>	<u>3303</u>	
S.			
A.	<u>3321</u>	<u>3309</u>	
R.			
PE.			
G.			
TD.	<u>3313</u>	<u>3322</u>	

Loc. in Sec. NE NE NE

Geol. _____
 Contr. Co.

Pool Vazec

		0
	OCT 24 '56	
COMPLETE		

Date Comm. 9-29-56

8" 363 W/185; D 1750 OCT 10 '56 5 1/2 3309
1150 OCT 17 '56 DD 3325 3318 8
3 Boph OCT 24 '56 2 1/2 8.18 B0
+ 16 BW in 8 hrs P. 25
Bopd + 20 Bw pd.

Co.

Loc.

No.

Sec.

T.

R.