


Section 9 Township 15 Range 13-W

Well No. #7 Rogg

Company R. H. Shields

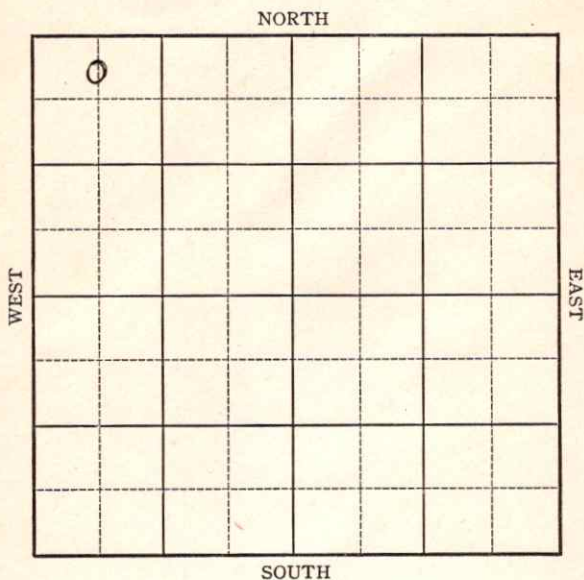

KANSAS

Russell

Sec. 9 Twp. 15 R. 13-W

Well No. #7 Rogg Farm

R. H. Shields Company


Trapp

330 Ft. from N. Line

_____ Ft. from S. Line

_____ Ft. from E. Line

660 Ft. from W. Line

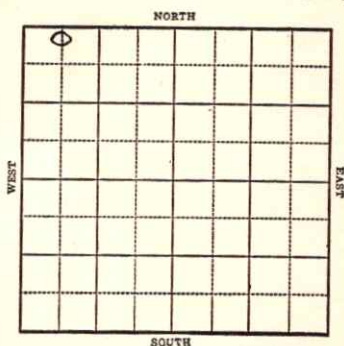

1943		REPORT
6/30	Derrick	
7/7	Cable rig.	
7/15	" "	
7/21	Drlg. 400'	
7/28	12" @ 455' Anhy 810' 10" @ 818	
8/4	Drlg. 1275' Drlg. 2225'	
8/11	8" @ 2447 T.D. 2560 UR 8"	
8/18	Lans 3021 6" @ 3040 Drlg. 3090	
8/25	Drlg. 3260'	
9/1	Arb 3312-40 T.D. HEW. 5" @ 3260'	
9/8	WOC. 95 shots 3045-73 -1000 acid	

OVER

1943

9/15 Lans 3021
Arb. 3312
5" @ 3260'
Perf. Lans
5000 acid
Pump 373 Pot. 38.1
Gravity 38.1
T.D. 3340'

COMPLETED

KANSAS

Map No. 72 Sec. 9 Twp. 15 R. 13W

Well No. 7 Rogg

R. H. Shields Company

FIRST REPORT Contractor

C NL NW NW

SECTION PLAT

330 Ft. from N. Line

_____ Ft. from S. Line

_____ Ft. from E. Line

660 Ft. from W. Line

o			

TRAPP POOL

Location _____

Rig up _____

Drilling and Remarks:

Derrick

RECORD

Cased _____ in., _____ ft.

Sand _____

Gas _____

Oil _____

Total Depth _____

PRODUCTION

1st 24 hrs. Nat. _____

1st 24 hrs. after shot _____

Gas _____ Cu. Ft.

Dry Hole _____

Abandoned _____

Date

JUN 30 1943 19

S. J. LEWIS Scout

KANSASMap No. 73 Sec. 9 Twp. 15 R. 13WWell No. 7 RoggR. H. Shields Company**COMPLETED**

Contractor

C N L NW NW

SECTION PLAT

330 Ft. from N. Line

_____ Ft. from S. Line

_____ Ft. from E. Line

660 Ft. from W. Line

0			

Trapp Pool

Location _____

Rig up _____

Drilling and Remarks:

*Lions 8021**Art 8312.**5" 8260**Prof. Lanes.**5000 acid**Pump 373 Pt**384 1/2*

RECORD

Cased _____ in., _____ ft.

Sand _____

Gas _____

Oil _____

Total Depth 3340

PRODUCTION

1st 24 hrs. Nat. _____

1st 24 hrs. after shot _____

Gas _____ Cu. Ft.

Dry Hole _____

Abandoned _____

Date

SEP 15 1943

19

S. J. LEWIS

Scout