


Section 6 Township 16 Range 10W

Well No. #3 Barclay

Company R. J. Shields et al

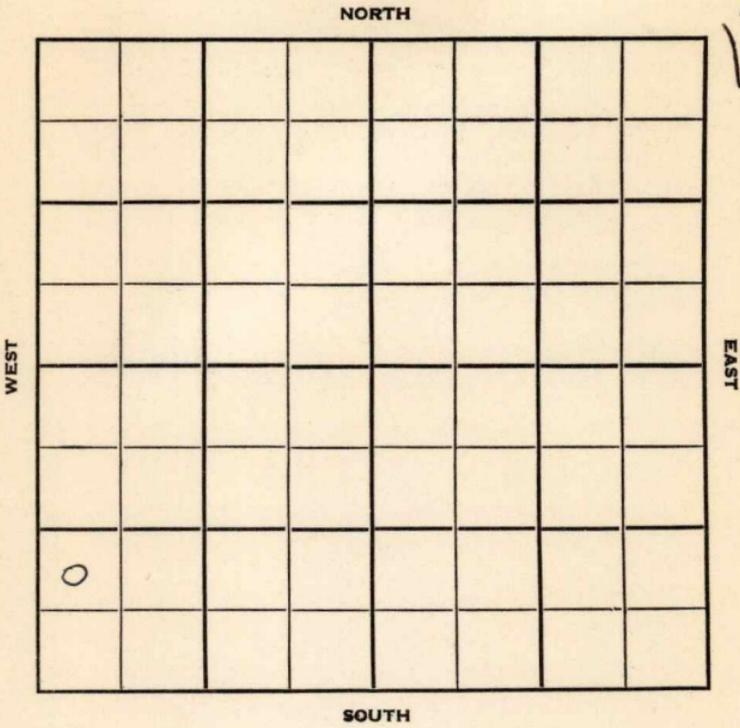

Ellsworth

KANSAS  
10W ✓

Sec. 6 Twp. 16 R. 10W

Well No. #3 Barclay Farm

R. J. Shields et al Company

Shields - Contr. Contractor

Stoltenberg Pool


\_\_\_\_\_ Ft. from N. Line

990' Ft. from S. Line

\_\_\_\_\_ Ft. from E. Line

330' Ft. from W. Line

NW SW SW

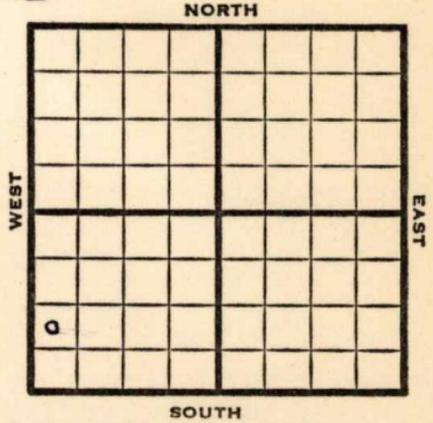

1950

Elev. 1973' ? REPORT

10/25

RUR

1951

1/10

Spud 10-26-50  
 Oil Well TD 3363  
 12" @ 485 Anhy 682  
 10" @ 692 7" @ 2880  
 KC 3031 Arb. 3345-62  
 5" @ 3345 TD 3363  
 500 A Comp. 50 bopd

**COMPLETED**



