


Section 9 Township 15 Range 13-W

Well No. #7 Kogg "B"

Company Cities Service

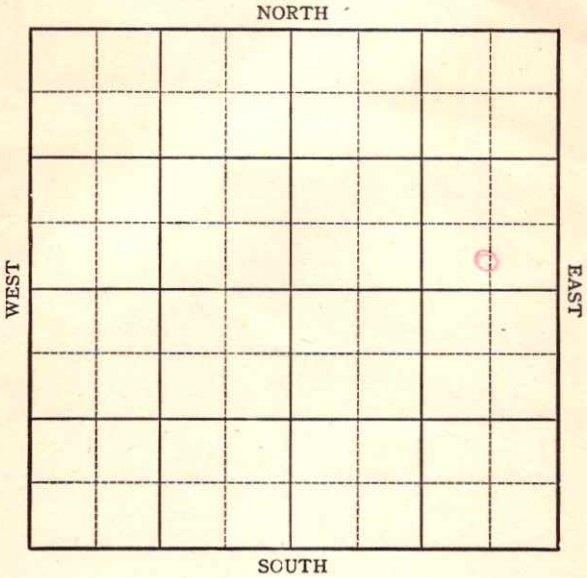

KANSAS

Russell County

Sec. 9 Twp. 15 R. 13W

Well No. #7 Rogg "B" Farm _____

Cities Service Company _____


Hall-Gurney

_____ Ft. from N. Line

330 Ft. from S. Line

660 Ft. from E. Line

_____ Ft. from W. Line

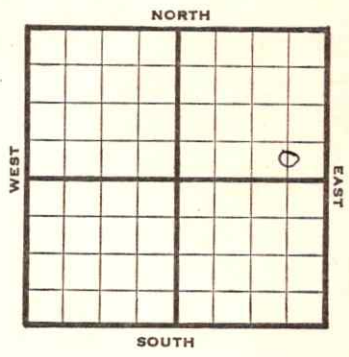

CSL SE NE

1946 1866 REPORT

- 8/21 Location
- 8/27 8" @ 362 WOC
- 9/5 **Lans 3026**
Drlg 31~~85~~'
- 9/10 **Arb 3323**
TD 3328
4" @ 3324 RUST
- 9/18 TD 3330'
PB 3192
Swb 16½ oil in 13 hrs
47 shots 3092-3225'
- 9/24 " " "
- 10/2 **Lans 3026'**
Arb 3323'
4" @ 3324'
Perf Lans 4000 acid
Pump 161 Oil Pot
TD 3330'
Grav 39.9

COMPLETED

Pool Name Hall-Gurney**KANSAS**

Kansas

Map No. 73 Sec. 9 Twp. 15 R. 13WWell No. 7 Rogg "B"

Cities Service Company

FIRST REPORT

Contractor

C S L S E N E

SECTION PLAT

 Ft. from N. Line330 Ft. from S. Line660 Ft. from E. Line Ft. from W. Line

			o

Russell County

Location XRig up

Drilling and Remarks:

RECORD

Cased in., ft.Sand Gas Oil Total Depth

PRODUCTION

1st 24 hrs. Nat. 1st 24 hrs. after shot Gas Cu. Ft.Dry Hole Abandoned

Date

AUG 21 1946 19

S. J. LEWIS Scout

