


FORM 51

KANSAS

Section 32 Township 16 Range 8W

Well No. #3 E.H. Hodgson "A"

Company Continental Oil

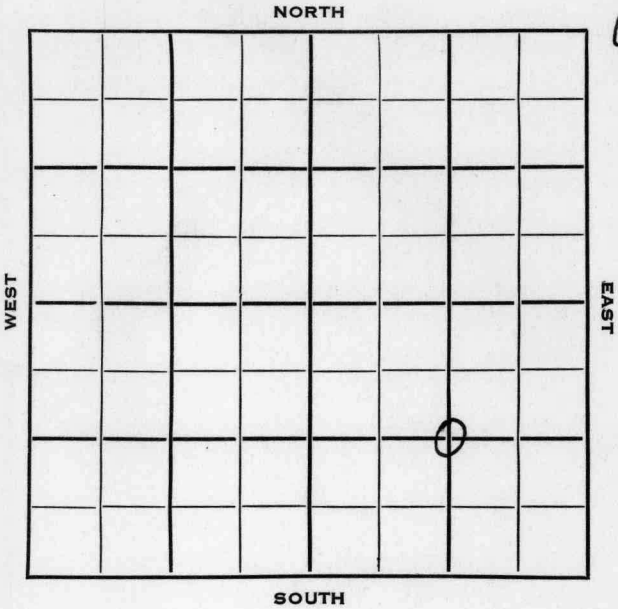

Ellsworth KANSAS

SEC.	TWP.	R.
32	16	8 W ✓

WELL NO.

3 E. H. Hodgson "A"

FARM

COMPANY

Continental Oil

CONTRACTOR

Anschutz Drlg.

Andrews Pool

_____ Ft. from N. Line

1320


_____ Ft. from S. Line

1320

_____ Ft. from E. Line

_____ Ft. from W. Line

C SE/4

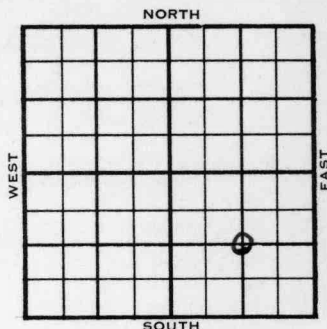

1953

ELEVATION

1681'

REPORT

10/7

Spud 9-29-53

9" @ 333

Drlg. 2758'

10/14

Heeb 2600' Br 11 2718' Lans 2738

Mq 3128' V 3159' Simp 3201'

Arb. 3345

Drlg. 3627'

10/21

RTD 3911' 5" @ 3411'

10/28

NR

11/4

"

11/11

"

11/18

"

12/16

"

1954

1/13

NR

1/20

"

1/27

Spud 9-29-53

SWD Well

TD 3911'

9" @ 333'

Heeb 2600', Br. Lime 2718', Lans 2738'

Maq. 3128', Viola 3140', Simp 3201',

1954

Information brought forward.

1/27

Arb 3345'

TP 3911'

5 @ 3411'

CO to 3911'

Regan 3865'

Comp for SWD Well.

ABANDONED

County Ellsworth State Kansas
 Sec. 32 (Blk.) 16 (Sur.) 8W Map No.
 Operator Continental Oil
 Well No. 3 Farm E. H. Hodgson "A"
 Elev. _____ Location C SE/4

FIRST REPORT

1320 Ft. From S Line SE
1320 Ft. From E Line Quarter
 Ist. Report OCT 7 1953
 Completion _____
 Remarks _____
Anschutz Drlg. - Contr.
 Spudding Date 9-29-53

Drlg. Data Andrews Pool
9" @ 333 drlg. 2758

County Ellsworth State Kansas
 Sec. 32 (Blk.) 16 (Sur.) 8W Map No.
 Operator Continental Oil
 Well No. 3 Farm E. H. Hodgson "A"
 Elev. 1681 Location C SE/4



1320Ft. From S Line SE
1320Ft. From E Line Quarter

1st. Report

Completion JAN 27 1954

Remarks Andrews Pool

Anschutz Drlg. - Contr.

Spudding Date 9-29-53

Drlg. Data SWD well TD 3911

9" @ 333 Heeb. 2600 Br. lime 2718

Lans. 2738 Maq. 3128 Viola 3140

Simp. 3201 Arb. 3345 TD 3911

5" @ 3411 CO to 3911 Regan 3865

Comp. for SWD well

J. G. McGEHEE