


Section 9 Township 15 Range 13-W

Well No. #2 Rogg "D"

Company Cities Service Oil

NORTH Coralena Pool

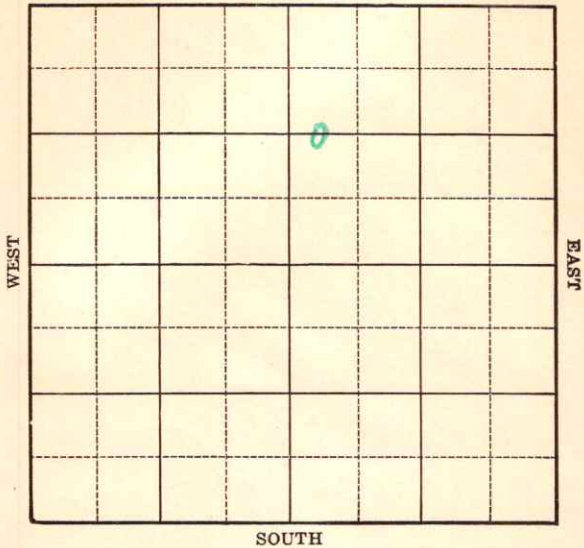

Sec. 9 Twp. 15 R. 13-W

Well No. #2 Rogg "D" Farm _____

Cities Service Oil Company _____

(Coralena)


1320 Ft. from N. Line

_____ Ft. from S. Line

_____ Ft. from E. Line

330 Ft. from W. Line

Elev. 1862

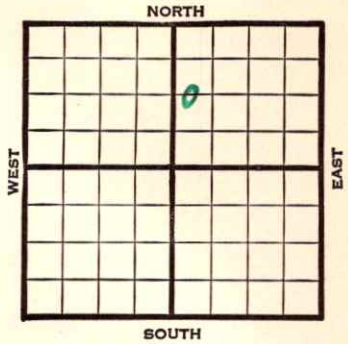

1940	REPORT
11/26	Rotary .
12/5	8" - 350' Drlg. 2125'
12/12	Lans. 3007' Pay 3025-66'
	Arb. 3320-21' T.D.
	5" - 3321' RUST.
12/19	6 shots 3026-36' 60 shots 3045 to 3067' 5000 acid. C.O.
12/26	Shut down.
12/30	Lans. 3007'
	Arb. 3320'
	5" - 3321'
	T.D. 3321'
	66 shots 3026-67'
	5000 acid.
	Potential 1113 bbls., flow.
	38.4 Gravity
	COMPLETED

Map No. 73 Sec. 9 Twp. 15 R. 13WWell No. 2 Rogg "D"Cities Service Oil Company

Contractor

FIRST REPORTC W L W $\frac{1}{2}$ NE1320 Ft. from N. Line

_____ Ft. from S. Line

_____ Ft. from E. Line

330 Ft. from W. Line**SECTION PLAT**

		o	

CORALENA POOL

Location _____

Rig up _____

Drilling and Remarks:

Rotary

RECORD

Cased _____ in., _____ ft.

Sand _____

Gas _____

Oil _____

Total Depth _____

PRODUCTION

1st 24 hrs. Nat. _____

1st 24 hrs. after shot _____

Gas _____ Cu. Ft.

Dry Hole _____

Abandoned _____

Date

NOV 26 1940

19

S. J. LEWIS

Scout

Map No. 73 Sec. 9 Twp. 15 R. 13WWell No. 2 Rogg "D"Cities Service Oil CompanyCOMPLETED ContractorC W L W $\frac{1}{2}$ NE

SECTION PLAT

		o	

1320 Ft. from N. Line

_____ Ft. from S. Line

_____ Ft. from E. Line

330 Ft. from W. Line

CORALENA POOL

Location _____

Rig up _____

Drilling and Remarks:

Law. 3007
Cu. 3320
5" C 3321
66 Skt to 3026-67
5000 cu. ft.
Flow 1113 Pa. Y.
38.4 Gr.

RECORD

Cased _____ in., _____ ft.

Sand _____

Gas _____

Oil _____

Total Depth 3321

PRODUCTION

1st 24 hrs. Nat. _____

1st 24 hrs. after shot _____

Gas _____ Cu. Ft.

Dry Hole _____

Abandoned _____

Date

DEC 30 1940 19S. J. LEWIS Scout