

KANSAS


FORM 51 5M 1-42 PETROL

Barton

Section 29 Township 16 Range 11-W

Well No. #4 Joseph

Company Gulf

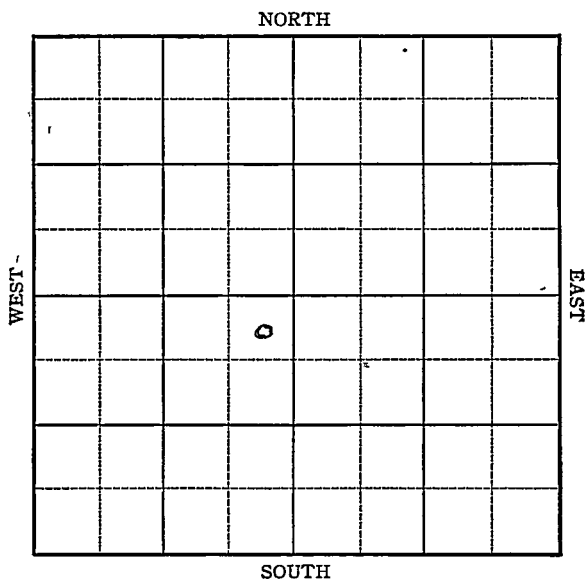

Sec. 29 Twp. 16 R. 11-W


Well No. #4 Joseph Farm
Gulf Company

330 Ft. from N. Line

 Ft. from S. Line

330 Ft. from E. Line

 Ft. from W. Line

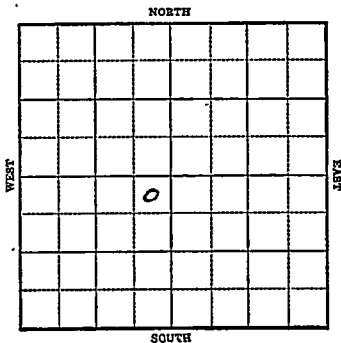

1944

R E P O R T

1-19 Cellar

1/26 8" @ 344

TD 344

No reason given skid rig to NE SE SW
ABD.

ABANDONED

Map No. KANSAS Sec. 29 Twp. 16 R. 11W

Well No. 4 Joseph

Gulf

Company

FIRST REPORT

Contractor

NE SW


SECTION PLAT

330 Ft. from N. Line

 Ft. from S. Line

330 Ft. from E. Line

 Ft. from W. Line

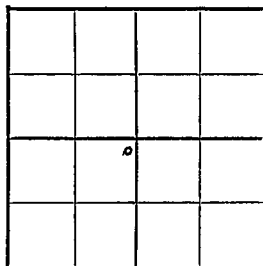

• Kraft Prusa Pool

Location

Rig up

Drilling and Remarks:

Cellar

RECORD

Cased in., ft.

Sand

Gas

Oil

Total Depth

PRODUCTION

1st 24 hrs. Nat.

1st 24 hrs. after shot

Gas Cu. Ft.

Dry Hole

Abandoned

Date

JAN 19 1940 19

S. J. LEWIS Scout

KANSAS
 Map No. _____ Sec. 29 Twp. 16 R. 11W

Well No. 4 Joseph

Gulf

Company

ABANDONED

Contractor

NE SW

SECTION PLAT

330

Ft. from N. Line

Ft. from S. Line

330

Ft. from E. Line

Ft. from W. Line

	o		

Kraft Prusa Pool

Location _____

Rig up _____

Drilling and Remarks:

8" @ 344AbandonedNo reason givenshut rigNEBELSON.

RECORD

Cased _____ in., _____ ft.

Sand _____

Gas _____

Oil _____

Total Depth 344

PRODUCTION

1st 24 hrs. Nat. _____

1st 24 hrs. after shot _____

Gas _____ Cu. Ft.

Dry Hole _____

Abandoned _____

Date

JAN 26 1944

19

S. J. LEWIS

Scout