

Ellsworth

Form 51-5M-2-29-34703

Map No. **KANSAS** Sec. 23 Twp. 16 R. 9w

Well No. 1 Farm Gregory

Peys Bros et al Company

NORTH

WEST

EAST

SOUTH

13

Location
Drilling Remarks

Rig Up
Drilling Remarks

RECORD


Cased _____ in. _____ ft.
Sand _____
Gas _____
Oil _____
Total Depth _____

PRODUCTION

1st 24 hrs. Nat. _____
1st 24 hrs. after shot _____
Gas _____ cu. ft.
Dry Hole _____
Abandoned _____

Map No. **KANSAS** Sec. 23 Twp. 16 R. 9W
Well No. 1- Gregory Farm
Keys Bros Oil Company

NORTH

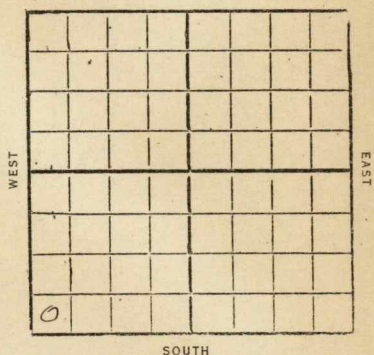

 Ft. from N. Line
330 Ft. from S. Line
 Ft. from E. Line
330 Ft. from W. Line
1931

Date

REPORT

6/17	Moving in reg
6/24	Bldg reg
7/1	reg
7/8	15"-200'
7/15	12"-405'
	Drlg 725'
7/22	TD 1245' Fishing
7/29	Drlg 1500'
8/5	" 1850'
8/12	" 2320'
8/19	SD 2320'
8/26	SD 2735' for 6" csg
9/2	
9/9	
9/16	TD 2960' VIR 8 1/4"
9/23	VIR 8 1/4"-3025'
9/30	8"-3125'
	drlg 3200'
10/7	HFW 3014'-25'
	8"-3125'
	TD 3155 Fishing
10/14	Drlg 3200'

10/21- Top Viola 3363
HFW 3590-3600
SD 3610

10/28 —

11/4- Top Viola 3363
HFW 3590-3600
TD 3610
Dry & Abandon

45 **KANSAS**

Ellsworth

Map No. Sec. 23 Twp. 16 R. 9 W

Well No. 1 Gregory

Kreys Bros et al Company

Contractor

FIRST REPORTS

Ft. from N. Line

330 Ft. from S. Line

Ft. from E. Line

330 Ft. from W. Line

SECTION PLAT

0			

Location

Rig up

Drilling and Remarks:

Moving in Rig.

RECORD

Cased in., ft.

Sand

Gas

Oil

Total Depth

PRODUCTION

1st 24 hrs. Nat.

1st 24 hrs. after shot

Gas Cu. Ft.

Dry Hole

Abandoned

Date

JUN 17 1931

192

CHAS. L. SHERWOOD

Scout

Ellsworth

45 KANSAS

Map No. Sec. 23 Twp. 16 R. 9 W

Well No. Gregory

Keys Bros & Co Company

Contractor

COMPLETED

SECTION PLAT

Ft. from N. Line

330 Ft. from S. Line

Ft. from E. Line

330 Ft. from W. Line

0			

ABANDONED

Location

Rig up

Drilling and Remarks:

Vela 3363

HFW 3590-3600

Data 3610

RECORD

Cased in. ft.

Sand

Gas

Oil

Total Depth 3610

PRODUCTION

1st 24 hrs. Nat.

1st 24 hrs. after shot

Gas Cu. Ft.

Dry Hole

Abandoned

Date

NOV 4 1931

192 CHAS. L. SHERWOOD Scout