


KANSAS

Russell

Section 9 Township 15 Range 13W

Well No. #6 Rogg "D"

Company Cities Service Oil

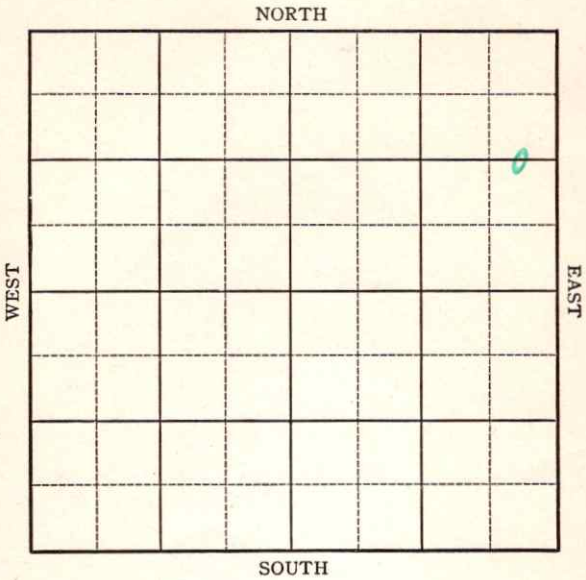

Russell


KANSAS

Map No. 73 Sec. 9 Twp. 15 R. 13WWell No. 6 Rogg "D"Cities Service Oil CompanyCOMPLETED Contractor

C E L N E

1320 Ft. from N. Line Ft. from S. Line330 Ft. from E. Line Ft. from W. Line

SECTION PLAT

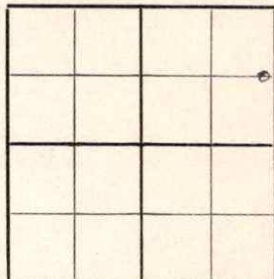

TRAPP POOL

Location Rig up

Drilling and Remarks:

Leas 30197" C 804910000 ac. ±Depth 1432 ft405 gr

RECORD

Cased in., ft.Sand Gas Oil Total Depth 3021

PRODUCTION

1st 24 hrs. Nat. 1st 24 hrs. after shot Gas Cu. Ft.Dry Hole Abandoned

Date

DEC 17 194119S. J. LEWIS

Scout

Russell


KANSAS

Map No. 15-23 Sec. 9 Twp. 15 R. 13WWell No. 6 Rogg "D"Cities Service Oil CompanyFIRST REPORT Contractor

C E L N E

1320 Ft. from N. Line Ft. from S. Line330 Ft. from E. Line Ft. from W. Line

SECTION PLAT

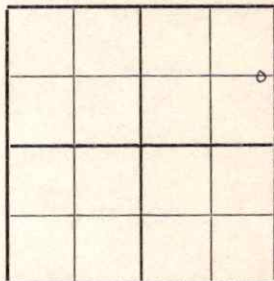

TRAPP POOL

Location Rig up

Drilling and Remarks:

Drlg. 335'

RECORD

Cased in., ft.Sand Gas Oil Total Depth

PRODUCTION

1st 24 hrs. Nat. 1st 24 hrs. after shot Gas Cu. Ft.Dry Hole Abandoned

Date

NOV 5 194119S. J. LEWIS

Scout