


Section 10 Township 15 Range 13 W

Well No. # 2 Anchultz

Company Keystone Pet.

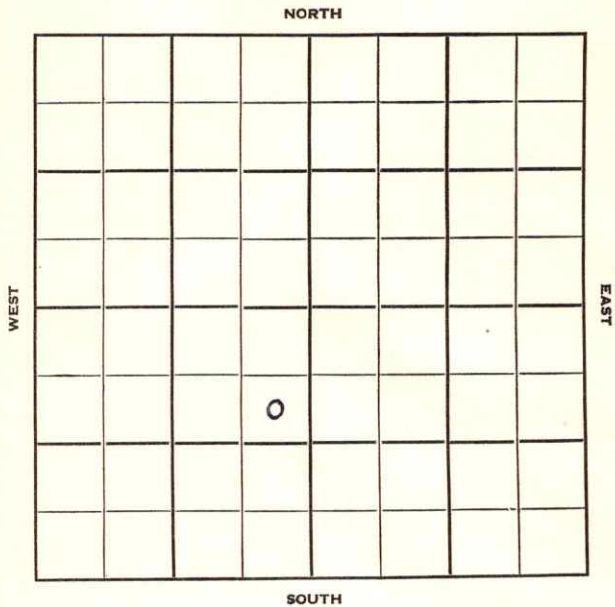

Sec. 10 Twp. 15 R. 13 W ✓

Well No. # 2 Anchultz Farm

Keystone Pet. Company

Keystone Contractor


990 Ft. from N. Line

_____ Ft. from S. Line

330 Ft. from E. Line

_____ Ft. from W. Line

SE NE SW

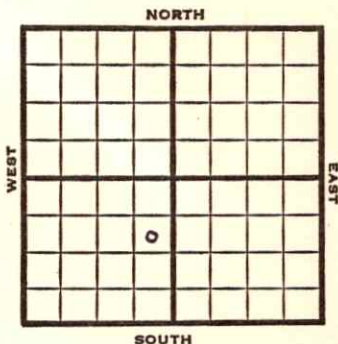

1951

Elev. 1849'

REPORT

3/7 Spud 3-5-51
Drilling

4/18 Spud 3-5-51
Oil well TD 3555'
15" @ 308 13" @ 490 10" @ 804
7" @ 2450, Tarkio 2470' 4 GOPH
8" @ 2598 Top 2710' pulled 7"
KC 3022', 7" @ 3022
TD 3555' 3000 A
Comp. 300 BOPD

COMPLETED

