

Trapp pool.

Russell Co.


FORM 51 10M 2-49 PETROL

KANSAS

Section 10 Township 15 Range 13W

Well No. #1 Anschutz

Company Keystone Drlg.

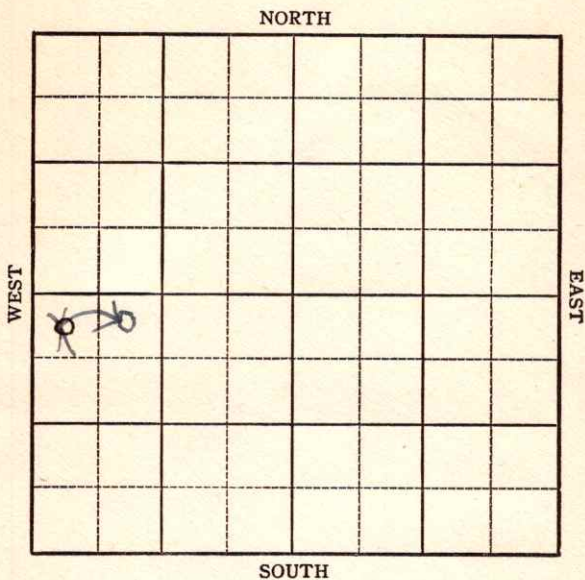

Russell

KANSAS

Sec. 10 Twp. 15 R. 13W

Well No. #1 Anschutz Farm

Keystone Drlg.

Company


Trapp Pool

330' Ft. from N. Line

 Ft. from S. Line

 Ft. from E. Line

330' Ft. from W. Line

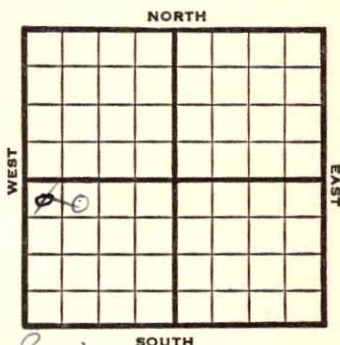

~~NW SW~~ *NE NW SW*

SOUTH

1949

Elev 1867'

REPORT

8/17	Location
8/24	"
8/31	"
9/7	"
9/14	"
9/21	"
9/28	"
10/5	"
10/12	"
10/19	"
10/26	Rig
11/1	"
11/9	"
11/16	"
11/23	"
11/29	"
12/7	"
12/14	"
12/21	"
12/28	"
1950	
3/29	TD 3355 In Cong
	15"@ 368'
	12"@ 520'
	10"@ 829'
	Topeka 2715'
	Lans 3045'
	Cong 3318'
	D&A
	Aband.

ABANDONED

Map No. _____ Sec. 10 Twp. 15 R. 13W

Well No. 1 Anschutz

Keystone Drlg. Company

Contractor

NW SW

FIRST REPORT
SECTION PLAT

330 Ft. from N. Line

_____ Ft. from S. Line

_____ Ft. from E. Line

330 Ft. from W. Line

o			

Russell County

Location X

Rig up _____

Drilling and Remarks:

RECORD

Cased _____ in., _____ ft.

Sand _____

Gas _____

Oil _____

Total Depth _____

PRODUCTION

1st 24 hrs. Nat. _____

1st 24 hrs. after shot _____

Gas _____ Cu. Ft.

Dry Hole _____

Abandoned _____

Date

AUG 17 1949

19

S. J. LEWIS

Scout

Map No. _____ Sec. 10 Twp. 15 R. 13WWell No. 1 Anschutz

Keystone Drllg.


Company

CORRECTION

Contractor

NE NW SW

SECTION PLAT

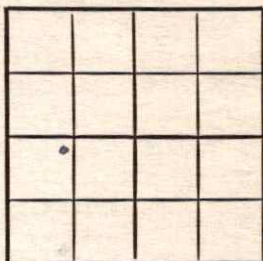330 Ft. from N. Line

_____ Ft. from S. Line

_____ Ft. from E. Line

990 Ft. from W. Line

Russell County

Location _____

Rig up _____

Drilling and Remarks:

Reported

NW SW

RECORD

Cased _____ in., _____ ft.

Sand _____

Gas _____

Oil _____

Total Depth _____

PRODUCTION

1st 24 hrs. Nat. _____

1st 24 hrs. after shot _____

Gas _____ Cu. Ft.

Dry Hole _____

Abandoned _____

Date

AUG 24 1949 19

S. J. LEWIS Scout

Kansas

Map No. _____ Sec. 10 Twp. 15 R. 13WWell No. 1 Anschutz

Keystone Drlg. _____ Company

Contractor

NE NW SW

E1. 1867
SECTION PLAT330 Ft. from N. Line

_____ Ft. from S. Line

_____ Ft. from E. Line

990 Ft. from W. Line

Russell County

Location _____

Rig up _____

Drilling and Remarks:

15" @ 368
 12" @ 520
 10" @ 829
 Lams 3045
 Cong 3318
 O+A

RECORD

Cased _____ in., _____ ft.

Sand _____

Gas _____

Oil _____

Total Depth 3355 in Cong.

PRODUCTION

1st 24 hrs. Nat. _____

1st 24 hrs. after shot _____

Gas _____ Cu. Ft.

Dry Hole _____

Abandoned _____

Date

MAR 29 1950

19

J. E. TYRA

Scout