



Ellsworth

**KANSAS**

Sec. 36 Twp. 16 R. 9W

Well No. #1 Janssen Farm

Bishop Oil et al Company


Wildcat Contractor

330 Ft. from N. Line

\_\_\_\_\_ Ft. from S. Line

\_\_\_\_\_ Ft. from E. Line

330 Ft. from W. Line

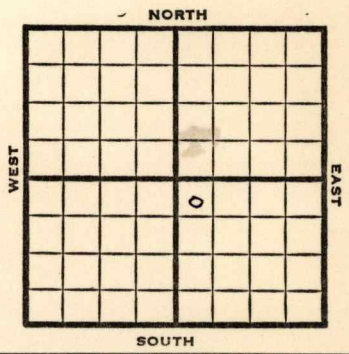

NW NW SE

1951

**Elev. 1754'**

**REPORT**

11/21

Spud 11-3-51  
10" @ 225'  
Drlg. 3222'

11/28

Spud 11-3-51  
D&A TD 3306  
10" @ 225'  
Heeb. 2685  
Lans. 2834  
Simp. 3211  
TD 3306  
D&A

**Br. Lime 2806**  
**Viola 3184**  
**Arb. 3288**

**ABANDONED**



