

KANSAS

Russell

FORM 51 5M 10-41 PETROL

O. W. D. D.

Section 10 Township 15 Range 13-W

Well No. #2 Anschutz

*Sohio Petr*


Company ~~Nate Appleman et al~~

Trapp Pool

NORTH

WEST

EAST

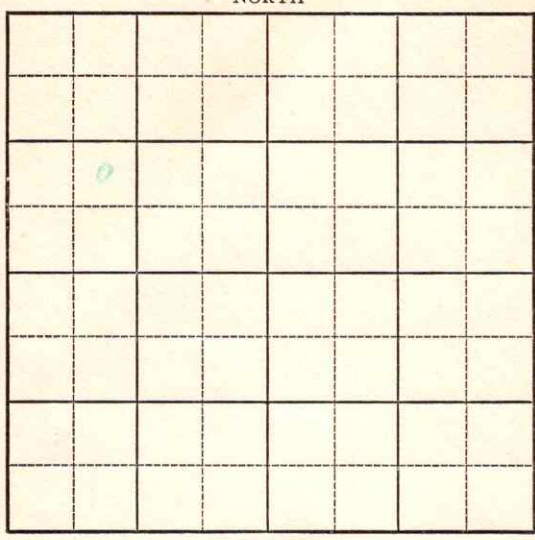

SOUTH

Sec. 10 Twp. 15 R. 13-W

Well No. #2 Anschutz Farm

*Sohio*

Nate Appleman et al Company


(Trapp) **O. W. D. D**

\_\_\_\_\_ Ft. from N. Line

990 Ft. from S. Line

\_\_\_\_\_ Ft. from E. Line

990 Ft. from W. Line

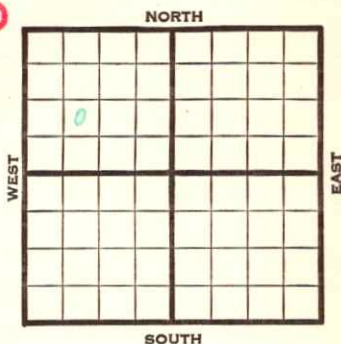

**Elev. 1869**

1942	REPORT
3/11	Cellar.
3/19	"
3/26	"
4/2	"
4/8	"
4/15	Rotary.
4/22	10" - 370' Drlg. 1723'
4/29	<b>Lans. 3025-58'</b> T.D. Run casing.
5/6	5" - 3055' T.D. 3081'
	1200' oil 6 hours. 8000 acid.
5/13	" " " "
5/20	<b>Lans. 3025'</b>
	5" - 3055'
	T.D. 3081'
	8000 acid.
	Bomb potential 16,900 bbls.
	Maximum 3000 bbls.
	39. Gravity
	<b>COMPLETED</b>
	<b>OVER</b>

1951

Elev. 1857'

**O. W. D. D**

5/23

Lans. 3025' OTD 3081

5" @ 3055 DD 3280'

7/11

Oil Well TD 3340

Lans. 3025 OTD 3081

5" @ 3055 DD 3280

Arb. 3327 DD 3334

1000 A PB 3104

B/121 goph CO to 3334

10 goph TD 3340 500 A

S/4 boph Comp. 60 bopd

**COMPLETED**







