

Sec. 2 Twp. 16 S Range 10 W  
#1 Lank

Kansas Geological Society  
Bennett + Gould  
Skelly Scout Tickets

Ellsworth

KANSAS

SEC.

2

TWP.

16S

R.

10W

WELL NO.

I Lank

FARM

COMPANY

Bennett & Gould

CONTRACTOR

Wildcat


13

\_\_\_\_\_ Ft. from N. Line

\_\_\_\_\_ Ft. from S. Line

\_\_\_\_\_ Ft. from E. Line

\_\_\_\_\_ Ft. from W. Line

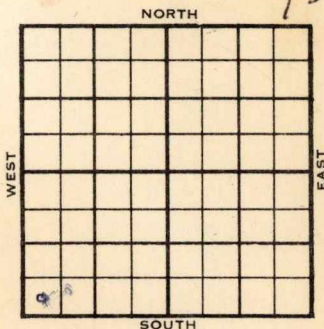

SW SW SW

1955

ELEVATION

1784'

REPORT

5/25

Heeb 2808'; Br Ls 2911; Lsg 2926;  
 BKC 3205; Congl 3253; Viola 3279;  
 Simp sh 3317; Arb 3376;  
 TD 3386; 8" 295; no log  
 D&A

FIRST REPORT

+

ABANDONED