

DX 78-1


Ellsworth

KANSAS

Section 3 Township 16 Range 10W

Well No. #1 Lank "A"

Company H. C. Bennett

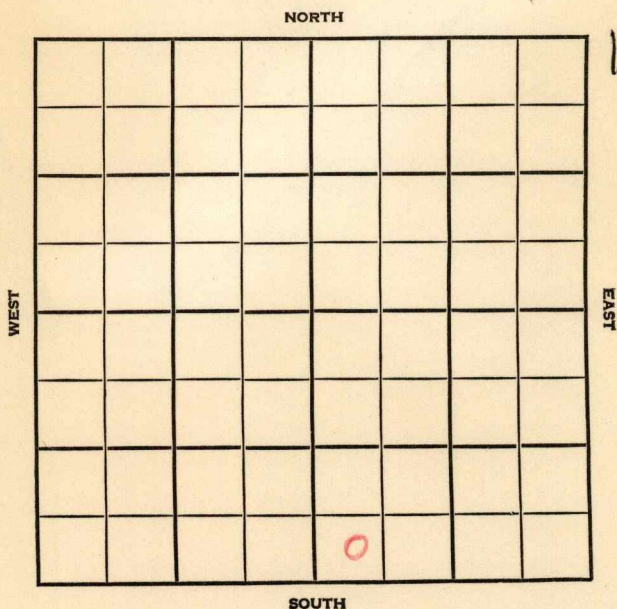

Ellsworth

KANSAS

|      |      |     |
|------|------|-----|
| SEC. | TWP. | R.  |
| 3    | 16   | 10W |

WELL NO.

1 Lank "A"

FARM

COMPANY

H. C. Bennett

CONTRACTOR

Progress Pool

Ft. from N. Line

330'


Ft. from S. Line

Ft. from E. Line

330'

Ft. from W. Line

SW SW SE

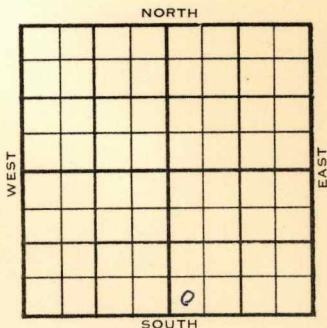

1955

ELEVATION

REPORT

5/25

Location

6/15

Comm. 6-1-55

8 5/8", @ 353/175, DST 3413-16, open  
 1 hr. Rec 35' oil, 210' ocs 1085/30"  
 D&A.

| Tops:  | Depth | Log  | Datum |
|--------|-------|------|-------|
| H.     | 2883  | 2880 | 1030  |
| Tr.    | 2903  | 2903 | 1053  |
| Dg.    | 2914  | 2910 | 1060  |
| B.L.   | 2987  | 2984 | 1134  |
| L.     | 3004  | 3002 | 1152  |
| B.K.C. | 3278  |      | 1428  |
| C.     | 3324  | 3324 | 1474  |
| V.     | 3371  | 3370 | 1520  |
| S.     | 3399  | 3380 | 1530  |
| A.     | 3412  | 3412 | 1562  |
| TD.    | 3432  |      |       |

ABANDONED



County Ellsworth ✓ Elev. 1850  
 Sec. 3 Twp. 16 Rge. 10W  
 Company H. C. Bennett  
 Farm Name Lank "A" No. 1

| TOPS   | DEPTH       | LOG         | DATUM       |
|--------|-------------|-------------|-------------|
| Anh.   |             |             |             |
| Tp.    |             |             |             |
| H.     | <u>2883</u> | <u>2880</u> | <u>1030</u> |
| Tr.    | <u>2903</u> | <u>2903</u> | <u>1053</u> |
| Dg.    | <u>2914</u> | <u>2910</u> | <u>1060</u> |
| Bl.    | <u>2987</u> | <u>2984</u> | <u>1134</u> |
| L.     | <u>3004</u> | <u>3002</u> | <u>1152</u> |
| K.C.   |             |             |             |
| B.K.C. | <u>3278</u> |             | <u>1428</u> |
| Ce.    |             |             |             |
| C.     | <u>3324</u> | <u>3324</u> | <u>1474</u> |
| M.     |             |             |             |
| M.     |             |             |             |
| K.     |             |             |             |
| Mz.    |             |             |             |
| Mq.    |             |             |             |
| V.     | <u>3371</u> | <u>3370</u> | <u>1520</u> |
| S.     | <u>3399</u> | <u>3380</u> | <u>1530</u> |
| S.     |             |             |             |
| A      | <u>3412</u> | <u>3412</u> | <u>1562</u> |
| R.     |             |             |             |
| Pe.    |             |             |             |
| G.     |             |             |             |
| T.D.   | <u>3432</u> |             |             |

Loc. in Sec. SW SW SE

Geol. \_\_\_\_\_

Contr. \_\_\_\_\_

Pool \_\_\_\_\_

Progress \_\_\_\_\_



Date Comm. 6-1-55 JUN 15 1955  
8 5/8" @ 353/175 DST 3413-16 open 1 hr  
 Rec. 35' oil 210' ocs w 1085/30"

D & A