


Section 10 Township 15 Range 13W

Well No. 2 Anschutz

Company Phillips Petroleum

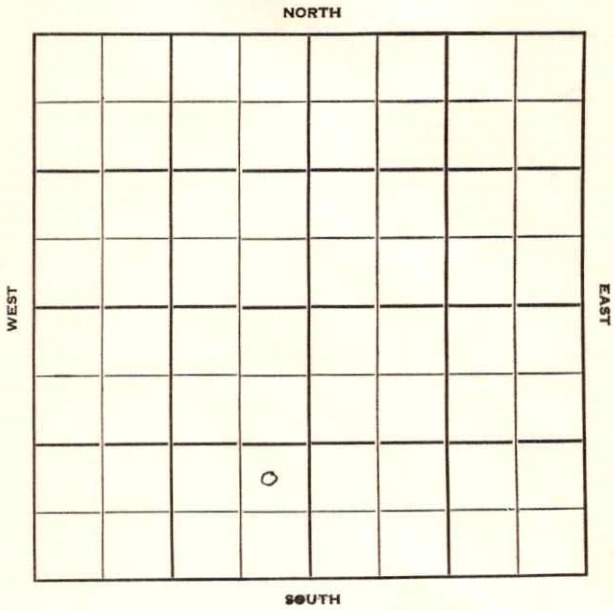

Russell

KANSAS ✓

Sec. 10 Twp. 15 R. 13 W

Well No. # 2 Anschutz Farm

Phillips Petroleum Company

Virginia Drlg. Contractor

Trapp Pool


Ft. from N. Line

990 Ft. from S. Line

330 Ft. from E. Line

Ft. from W. Line

NE SE SW

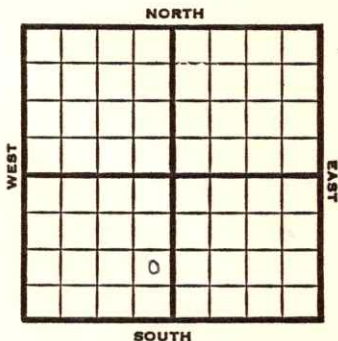

1951

Elev. 1853' REPORT

7/25
9/19

Location
 Spud 8-3-51
 Oil well TD 3321' 8" @ 817'
 Anhy 810' Tarkio 2442' Top 2722'
 Heeb 2953' Tor. 2969' Lans. 3030'
 Cong. 3308' Arb. 3310-13'
 5" @ 3312' TD 3321' 500 A
 S/5 BOPH
 Comp. 60 BOPD 12 BW

COMPLETED

