
Russell County
FORM 51 10M 8-47

KANSAS

Section 6 Township 15 Range 14W

Well No. 1 Vonfelt

Company G. W. Chenoweth

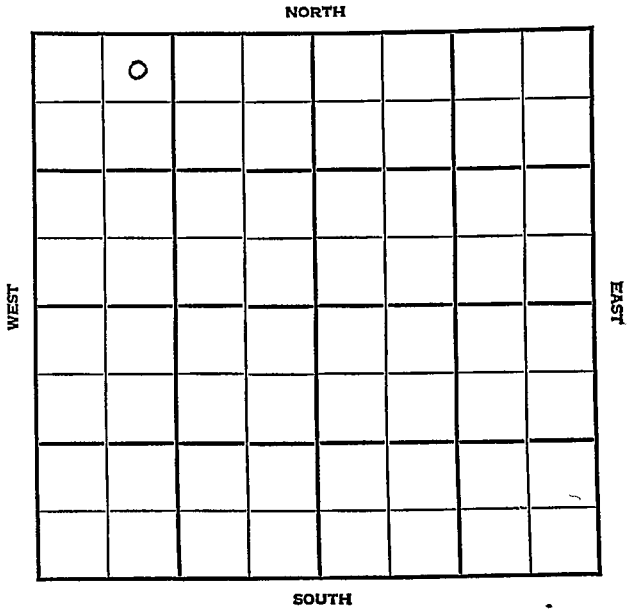

FORM 252-A
5M 9-47 PETROL

Russell KANSAS

Sec. 6 Twp. 15 R. 14W

Well No. #1 Vonfelt Farm

G. W. Chenoweth Company

Big Creek


330 Ft. from N. Line

Ft. from S. Line

Ft. from E. Line

990 Ft. from W. Line

NE NW NW

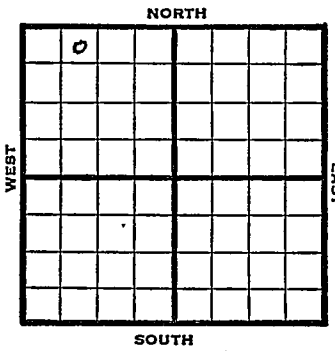

1947	Elev. 1780' REPORT
12/23	Rig
12/30	Spud.
1948	
1/7	SD
1/14	Drlg 465'
1/21	10" @ 792' Drlg. 1240'
1/26	Drlg 1610'
2/4	8" @ 2425' Drlg. 2780'
2/11	Topeka 2680' Lansing 2968' Drlg. 3070'
2/18	Conglomerate 3219-21' TD3221'
2/25	Cong. 3219' TD 3224' Abd.

ABANDONED

Form 26 200 Bks. 10-46 Petrol

Kansas

Big Creek Pool

Map No. ____ Sec. 6 Twp. 15 R. 14W

Well No. 1 Vonfelt

G. W. Chenoweth Company

FIRST REPORT Contractor

NE NW NW


330 Ft. from N. Line

____ Ft. from S. Line

____ Ft. from E. Line

990 Ft. from W. Line

SECTION PLAT

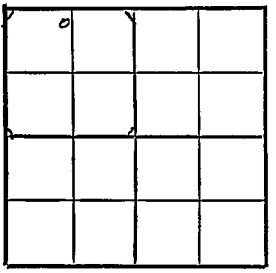

Russell County

Location

Rig up

Drilling and Remarks:

Rig

RECORD

Cased ____ in., ____ ft.

Sand

Gas

Oil

Total Depth

PRODUCTION

1st 24 hrs. Nat.

1st 24 hrs. after shot.

Gas ____ Cu. Ft.

Dry Hole

Abandoned

Date

DEC 2 3 1947 19

S. J. LEWIS Scout

Form 26—200 Bks.—1-48—Palace

Big Creek Pool

Kansas

Map No. 73 Sec. 6 Twp. 15 R. 14W

Well No. 1 Vonfelt


G. W. Chenoweth Company

ABANDONED Contractor

NENW NW

E. 1788

SECTION PLAT

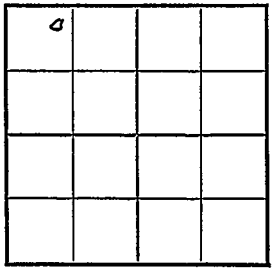

330 Ft. from N. Line

Ft. from S. Line

Ft. from E. Line

990 Ft. from W. Line

Russell County

Location

Rig up

Drilling and Remarks:

Comp 8218

RECORD

Cased in., ft.

Sand

Gas

Oil

Total Depth 3224

PRODUCTION

1st 24 hrs. Nat.

1st 24 hrs. after shot

Gas Cu. Ft.

Dry Hole

Abandoned

Date

FEB 25 1948 19 S. J. LEWIS Scout