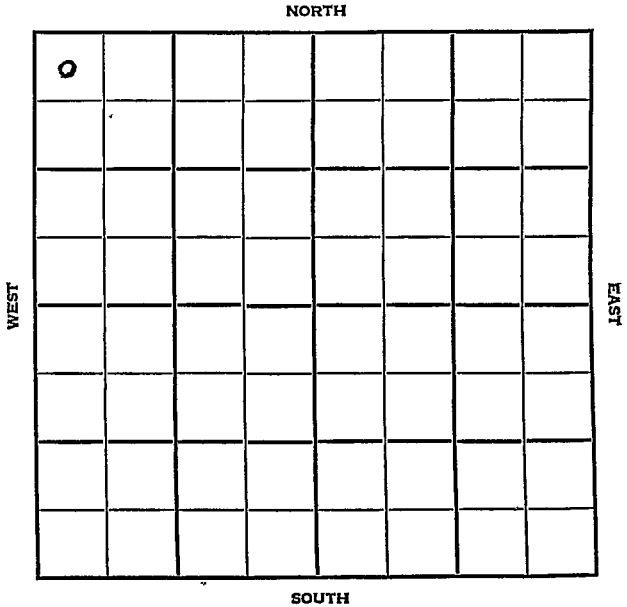


DX 78-1

Section 7 Township 15 Range 11WWell No. 1 DewaldCompany Musgrove Pet.

Russell KANSAS		
SEC	TWP	R
7	15	14W 1
WELL NO		
1 Dewald		FARM
COMPANY		

Musgrove Pet

CONTRACTOR


Musgrove-Contr
Big Creek Pool

330 Ft from N Line

Ft from S Line

Ft from E Line

330 Ft from W Line

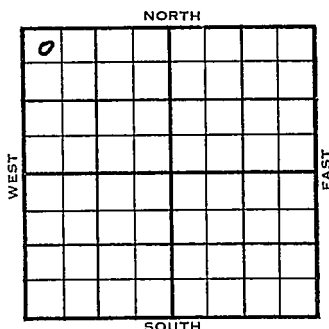

NW NW NW

1954	ELEVATION	REPORT
	1777	
6/15	M I R	
6/23	8" @ 531' w/185 sks Anhy 810', Tarkio 2374' rlg. 2 815'	
6/30	Spudding 6016-54 D & A TD 3242 8" @ 531 Anhy 810 Tarkio 2374 Heeb 2923 Tohy 2941 Lans. 2983 DST 2984 -3020 opeb 1 hr. Rec. 45' mud 600# TD 3242 D&A	

ABANDONED

County Russell State KansasSec. 7 (Blk. Twp.) 15 (Sur. Rge) 14W Map No.Operator Musgrove Pat.Well No. 1 Farm DewaldElev. Location NW NW NW

0					

FIRST REPORT

330 Ft. From N Line NW330 Ft. From W Line Quarter1st. Report JUN 15 1954

Completion


Remarks

Musgrove - Contr.

Spudding Date

Drlg. Data Big Creek PoolM I R

J. G. McGEHEE

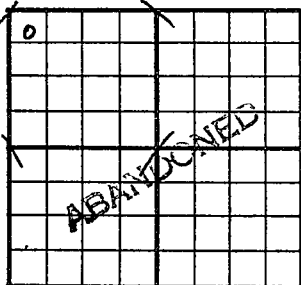County Russell State KansasSec. 7 (Blk. Twp) 15 (Sur. Rge) 14W Map No.Operator Musgrove Pet.Well No. 1 Farm DewaldElev. 1771 Location NW NW NW330 Ft. From N Line NW330 Ft. From W Line Quarter1st. Report JUN 30 1954

Completion

Remarks Big Creek PoolMusgrove - Contr.Spudding Date 6-16-54Drlg. Data D & A TD 32428" @ 531 Anhy 810 Tarkio 2374Heeb. 2923 Tor. 2941 Lans. 2983DST 2984-3020 open 1 hr. Rec. 45' mud600# TD 3242D & A

J. G. McGEHEE