

KANSAS


Russell

FORM 51 5M 1-42 PETROL

Section 9 Township 15 Range 14-W

Well No. #1 Krug "B"

Company Pryor & Lockhart

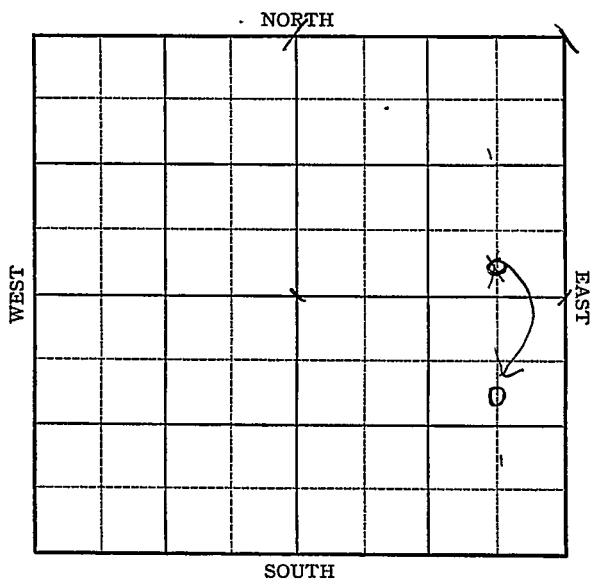

KANSAS

Russell

Sec. 9 Twp. 15 R. 14-W

Well No. #1 Krug "B" Farm

Pryor & Lockhart Company


Wildcat

990 Ft. from N. Line

-330 Ft. from S. Line

660 Ft. from E. Line

 Ft. from W. Line

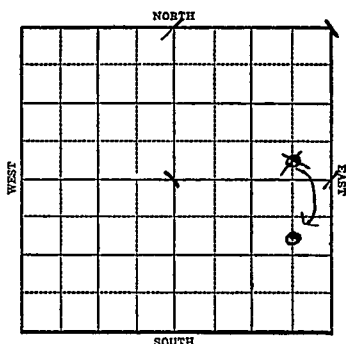

1943

R E P O R T

6/23 Drlg. 800'

6/30 15" @ 55'
13" @ 420'
Anhy 779'
10" @ 785'

7/7 Drlg. 2100'
8" @ 2436
Ldlg. 2670'

7/15 Lans 2998
7" @ 3160
Arb 3258
T.D. 3260
Run 5"

7/21 Arb. 3258
5" @ 3260'
T.D. 3276'

HFW

ABANDONED

Russell

KANSAS

Map No. 73 Sec. 9 Twp. 15 R. 14WWell No. 1 Krug "B"

Pryor & Lockhart

Company

FIRST REPORT

Contractor


C S L S E N E

SECTION PLAT

_____ Ft. from N. Line

330 Ft. from S. Line660 Ft. from E. Line

_____ Ft. from W. Line

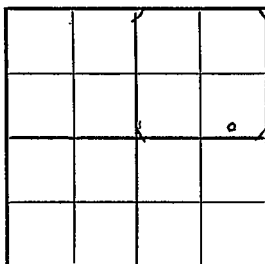

WIIDCAT

Location _____

Rig up _____

Drilling and Remarks:

Drlg. 800'

RECORD

Cased _____ in., _____ ft.

Sand _____

Gas _____

Oil _____

Total Depth _____

PRODUCTION

1st 24 hrs. Nat. _____

1st 24 hrs. after shot _____

Gas _____ Cu. Ft.

Dry Hole _____

Abandoned _____

Date

JUN 23 1943

19

S. J. LEWIS Scout

KANSAS

Russell

Map No. 73 Sec. 9 Twp. 15 R. 14W

Well No. 1 Krug "B"

Pryor & Lockhart

Company

CORRECTION

Contractor

C SL NE SE

990 Ft. from N. Line

_____ Ft. from S. Line

660 Ft. from E. Line

_____ Ft. from W. Line

SECTION PLAT

			o

TRAP POOL

Location _____

Rig up _____

Drilling and Remarks:

Reported as

C SL SE NE

RECORD

Cased _____ in., _____ ft.

Sand _____

Gas _____

Oil _____

Total Depth _____

PRODUCTION

1st 24 hrs. Nat. _____

1st 24 hrs. after shot _____

Gas _____ Cu. Ft.

Dry Hole _____

Abandoned _____

Date

JUN 3 0 1943

19

S. J. LEWIS

Scout

KANSAS

Map No. 73 Sec. 9 Twp. 15 R. 14WWell No. 1 Krug "B"Pryor & Lockhart CompanyABANDONED Contractor

SECTION PLAT

990 C S L NE SE
Ft. from N. Line275 Ft. from S. Line660 Ft. from E. Line Ft. from W. Line

			0

Trapp Pool

Location Rig up

Drilling and Remarks:

*Cer Y3258**5" @ 2260**HPW.*

RECORD

Cased in., ft.Sand Gas Oil Total Depth 3226

PRODUCTION

1st 24 hrs. Nat. 1st 24 hrs. after shot Gas Cu. Ft.Dry Hole Abandoned

Date

JUL 21 194319S. J. LEWIS

Scout