


Section 9 Township 15 Range 14 -W

Well No. #1 Frederick

Company Phillips

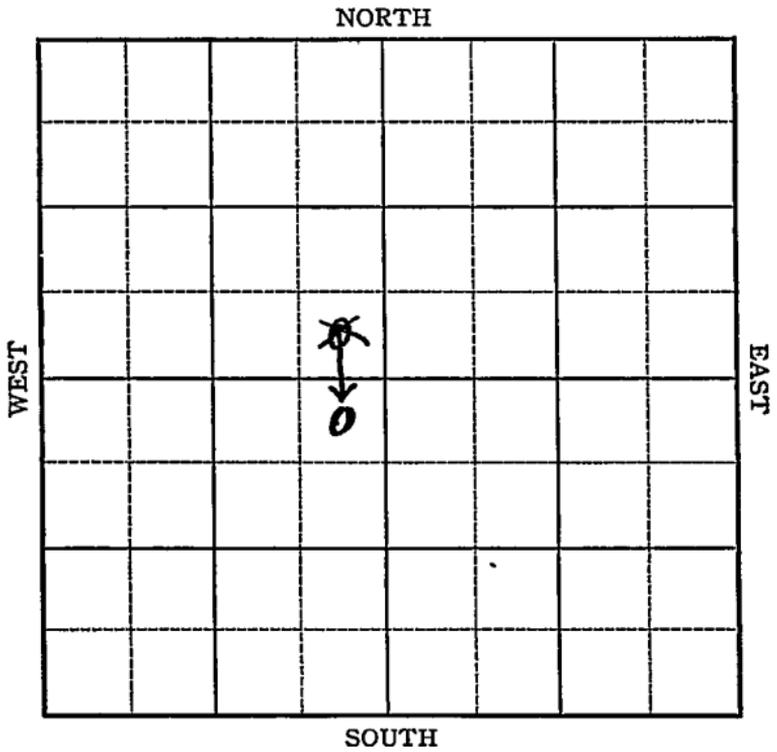

Sec. 9 Twp. 15 R. 14-W

Well No. #1 Frederick Farm

Phillips Company

(Trapp)


330 Ft. from N. Line

~~330~~ Ft. from S. Line

330 Ft. from E. Line

_____ Ft. from W. Line

Elev. 1824

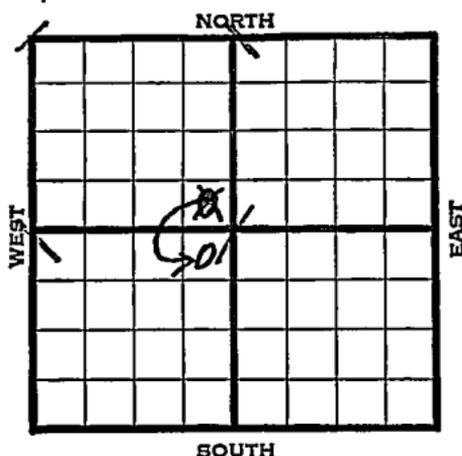

REPORT	
1941	
9/24	Location
10/2	8" - 633' Anhy 835'
	Drlg. 1960'
10/9	Lans. 3028' S.S.O. 3028-30 & 3202-04' Arb. 3294'
	T.D. 3301' S.O. Run esg.
10/16	T.D. 3301' 5" - 3292' RUST.
10/23	" " " " "
10/30	T.D. 3299' 4000 acid.
	Shot 10 qts. C.O.
11/6	Drlg. 3309'
11/13	TD 3309' P.B.
11/20	T.D. 3314' water. P.B. to 2775'
11/25	Arb. 3292'
	5" - 3292'
	T.D. 3299'
	Water.
	ABANDONED

Map No. A-23 Sec. 9 Twp. 15 R. 14W

Well No. 1 Fredrick

Phillips Company

CORRECTION Contractor

SECTION PLAT

		o	

NE SW

330 Ft. from N. Line

_____ Ft. from S. Line

330 Ft. from E. Line

_____ Ft. from W. Line

TRAPP POOL

Location _____

Rig up _____

Drilling and Remarks:

Had it spotted
wrong

RECORD

Cased _____ in., _____ ft.

Sand _____

Gas _____

Oil _____

Total Depth _____

PRODUCTION

1st 24 hrs. Nat. _____

1st 24 hrs. after shot _____

Gas _____ Cu. Ft.

Dry Hole _____

Abandoned _____

Date

SEP 24 1941 19

S. J. LEWIS Scout

Map No. 173 Sec. 9 Twp. 15 R. 14WWell No. 1 FrederickPhillips

Company

ABANDONED

Contractor

NE SW

SECTION PLAT

330 Ft. from N. Line

Ft. from S. Line

330 Ft. from E. Line

Ft. from W. Line

TRAPP POOL

Location _____

Rig up _____

Drilling and Remarks:

*Cor 3292**5" @ 3292**Water*

RECORD

Cased _____ in., _____ ft.

Sand _____

Gas _____

Oil _____

Total Depth 3299

PRODUCTION

1st 24 hrs. Nat. _____

1st 24 hrs. after shot _____

Gas _____ Cu. Ft.

Dry Hole _____

Abandoned _____

Date

NOV 25 1941 19S. J. LEWIS Scout