


KANSAS Russell

FORM 51 5M 10-41 PETROL

Section 10 Township 15 Range 14-W

Well No. 1 ~~Krug~~ Boxberger

Company Pryor & Lockhart et al

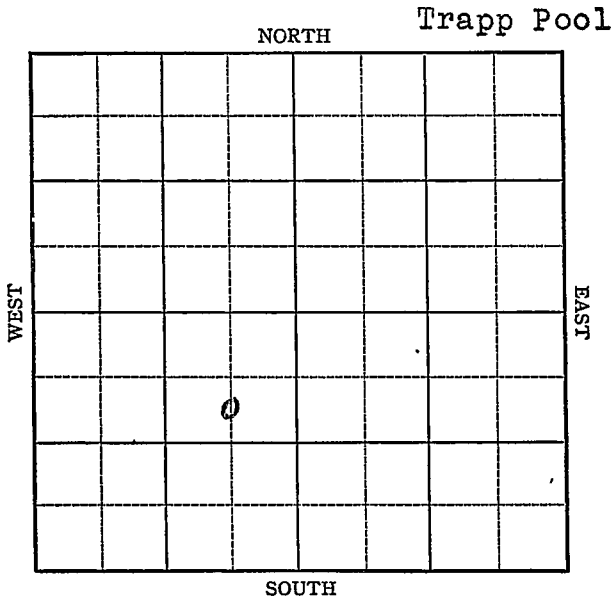

Map No. 23 Sec. 10 Twp. 15 R. 14WWell No. 1 KrugPryor & Lockhart et al. Company**FIRST REPORT**

Contractor

C SL NE SW


990 Ft. from N. Line

_____ Ft. from S. Line

660 Ft. from E. Line

_____ Ft. from W. Line

SECTION PLAT

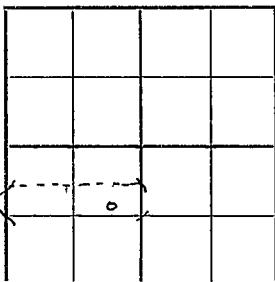**TRAPP POOL**Location XXX

Rig up _____

Drilling and Remarks:

RECORD

Cased _____ in., _____ ft.

Sand _____

Gas _____

Oil _____

Total Depth _____

PRODUCTION

1st 24 hrs. Nat. _____

1st 24 hrs. after shot _____

Gas _____ Cu. Ft.

Dry Hole _____

Abandoned _____

Date

JAN 21 1942 19S. J. LEWIS Scout

Map No. 23 Sec. 10 Twp. 15 R. 14WWell No. 1 BoxbergerPryor & Lockhart et al. Company

CORRECTION

Contractor

C SL NE SW

990 Ft. from N. Line

_____ Ft. from S. Line

660 Ft. from E. Line

_____ Ft. from W. Line

SECTION PLAT

TRAPP POOL

Location _____

Rig up _____

Drilling and Remarks:

Reported as #1 Krug

RECORD

Cased _____ in., _____ ft.

Sand _____

Gas _____

Oil _____

Total Depth _____

PRODUCTION

1st 24 hrs. Nat. _____

1st 24 hrs. after shot _____

Gas _____ Cu. Ft.

Dry Hole _____

Abandoned _____

Date

FEB 4 1942 19

S. J. LEWIS Scout

Map No. 23 Sec. 10 Twp. 15 R. 14WWell No. 1 BoxbergerPryor & Lockhart et al. Company**COMPLETED**

Contractor

C SL NE SW

990 Ft. from N. Line

_____ Ft. from S. Line

660 Ft. from E. Line

_____ Ft. from W. Line

SECTION PLAT

TRAPP POOL

Location _____

Rig up _____

Drilling and Remarks:

*Ch 8222.**5" @ 3230**1500 acid
Pump 311 P.D.**39° SW*

RECORD

Cased _____ in., _____ ft.

Sand _____

Gas _____

Oil _____

Total Depth 3235

PRODUCTION

1st 24 hrs. Nat. _____

1st 24 hrs. after shot _____

Gas _____ Cu. Ft.

Dry Hole _____

Abandoned _____

Date

MAR 25 1942 19

S. J. LEWIS Scout