


Section 16 Township 30 Range 4E

Well No. #42 Rock Unit

Company E. B. Shauver

NORTH

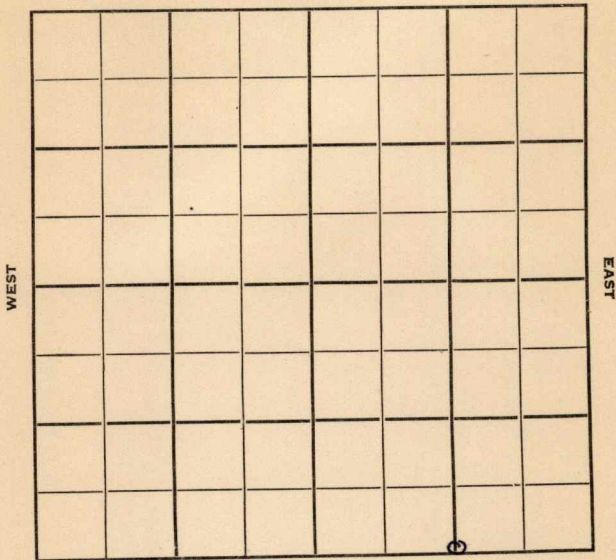

SOUTH

Sec. 16 Twp. 30 R. 4E

Well No. #42 Rock Unit Farm

E. B. Shauver Company

Shauver Contractor


Ft. from N. Line

60 Ft. from S. Line

1320 Ft. from E. Line

Ft. from W. Line

C S/2 S/2 SE

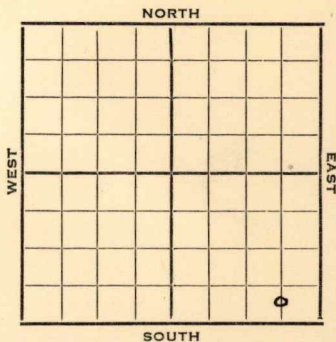

1952 Elev. 1170' REPORT

5/28 Spud 5-20-52  
8" @ 53'  
Stal 1840  
Drlg. 2030'

6/11 Spud 5-20-52  
SWD well TD 2794  
8" @ 53' Stal. 1835 KC 2220  
TD 2770 5" @ 2767'  
Bart. 2767 DD 2794 PB 2793  
Comp. SWD well

COMPLETED



