


Section 3 Township 29 Range 6E

Well No. 9 - Need

Company Dunn & Strait

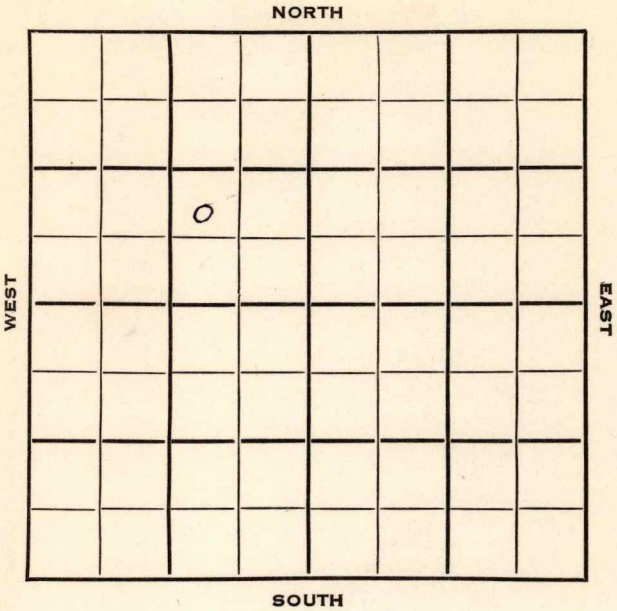

Butler

KANSAS



Sec. 3 Twp. 29 R. 6 E

Well No. # 9 Need Farm

Dunn & Strait Company

Dunn & Strait Contractor


_____ Ft. from N. Line

990 Ft. from S. Line

990 Ft. from E. Line

_____ Ft. from W. Line

NW SE NW

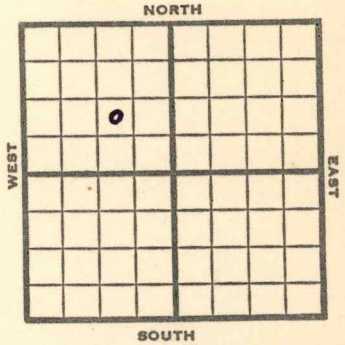

1953

Elev. 1429

REPORT

1/21
2/11

RUR

Spudding Date 1/20/53

Oil Well TD 2838

8" @ 70 Lans. 1770 KC 2177 B KC 2362

Bart. 2780 TD 2792 5" @ 2785 DD 2838

Comp. 25 bopd

COMPLETED

