


Section 10 Township 14 Range 14W

Well No. #3 S. Boxberger

Company H.E. Blair Drlg.

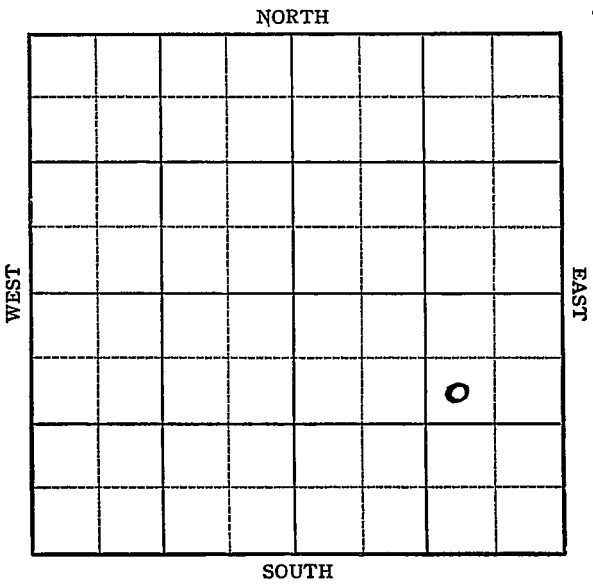

Sec. 10 Twp. 14 R. 14W

Well No. #3 S. Boxberger Farm

H.H. Blair Drlg. Company


Williamson

990 Ft. from N. Line

_____ Ft. from S. Line

990 Ft. from E. Line

_____ Ft. from W. Line

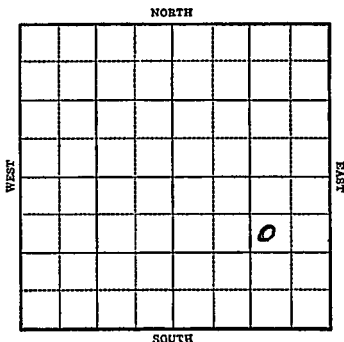

1944

R E P O R T

2/23

Location

3/1

"

3/8

"

3/16

Cable rig

3/22

" "

3/29

" "

4/5

" "

4/12

" "

4/19

15" @ 370

12" @ 543

Anhy 833

10" @ 842

Drlg. 1150

4/26

Drlg. 2125

5/3

8" @ 2508 CO

OVER

1944

5/6

Gas 2385-2390

Good show oil 2895-2905

Dodge 2960

Lans 3001-7" @3002'

Drlg. 3003'

5/17

Pay 3012-18

Total Depth 3023

1800' oil - 12 hrs

500 acid

5/24

7" @ 3002

Lans 3001

T^D 3023

5000 acid

Pump 353 Pot

Gravity 36.7

COMPLETED

KANSAS

Map No. 72 Sec. 10 Twp. 14 R. 14W

Well No. 3 S. Boxberger

H.H. Blair Drlg. Company

FIRST REPORT Contractor

SW NE SE

SECTION PLAT

990 Ft. from N. Line

_____ Ft. from S. Line

990 Ft. from E. Line

_____ Ft. from W. Line

			o

Williamson Pool

Location X

Rig up _____

Drilling and Remarks:

RECORD

Cased _____ in., _____ ft.

Sand _____

Gas _____

Oil _____

Total Depth _____

PRODUCTION

1st 24 hrs. Nat. _____

1st 24 hrs. after shot _____

Gas _____ Cu. Ft.

Dry Hole _____

Abandoned _____

Date

FEB 23 1944 19

S. J. LEWIS Scout

Pool Name WilliamsonKANSAS 2
Map No. 7 Sec. 10 Twp. 14 R. 14WWell No. 3 S. BoxbergerH. F. Blair Drlg. Company**COMPLETED**

Contractor

SW NE SE

SECTION PLAT

990 Ft. from N. Line Ft. from S. Line990 Ft. from E. Line Ft. from W. Line

			6

Russell County

Location _____

Rig up _____

Drilling and Remarks:

*Lease 3001**7" @ 3002**5000 aciol**Pump 353 ~~PT~~**367 Gr.*

RECORD

Cased _____ in., _____ ft.

Sand _____

Gas _____

Oil _____

Total Depth 3023

PRODUCTION

1st 24 hrs. Nat. _____

1st 24 hrs. after shot _____

Gas _____ Cu. Ft.

Dry Hole _____

Abandoned _____

Date

MAY 24 1944 19 _____ S. J. LEWIS Scout