

Section 3 Township 29 Range 6EWell No. #13 NeedCompany Dunn & Strait

		0					

NORTH

WEST

EAST

SOUTH

Butler

KANSAS

Sec. 3 Twp. 29 R. 6EWell No. #13 Need FarmDunn & Strait Company

Contractor


990 Ft. from N. Line

Ft. from S. Line

990 Ft. from E. Line

Ft. from W. Line

SW NE NW

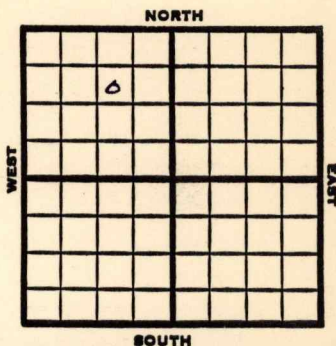

1953

Elev. -

REPORT

3/11

Spudded 3/6/53

12" @ 65

Drlg. 1143

3/25

Spud 3-6-53

Oil Well

TD 2847

12" @ 65

Bart 2801

TD 2807

5" @ 2801

DD 2847 Comp. 25 bopd

COMPLETED

County Butler State Kansas
Sec. 3 (Blk.) 29 (Sur.) 6E Map No.
Operator Dunn & Strait
Well No. 13 Farm Need
Elev. Location SW NE NW

990 Ft. From N Line NW

990 Ft. From E Line Quarter

1st. Report MAR 11 1953

Completion

Remarks

Spudding Date 3-6-53

Drlg. Data

12" @ 65 drlg. 1143

J. G. McGEHEE

County Butler State Kansas

Sec. 3 (Blk. Twp.) 29 (Sur. Rge.) 6E Map No.

Operator Dunn & Strait

Well No. 13 Farm Need

Elev.	Location	SW	NE	NW
-------	----------	----	----	----

990 Ft. From N Line NW

990 Ft. From E Line Quarter

1st. Report

Completion MAR 25 1953

Remarks

Spudding Date 3-6-53

Drlg. Data Oil well TD 2847

12" @ 65 Bart. 2801 TD 2807

5" @ 2801 DD 2847 Comp. 25 bopd