


Section 10 Township 14 Range 14W

Well No. #5 Newcomer "C"


Company B & R Drlg.

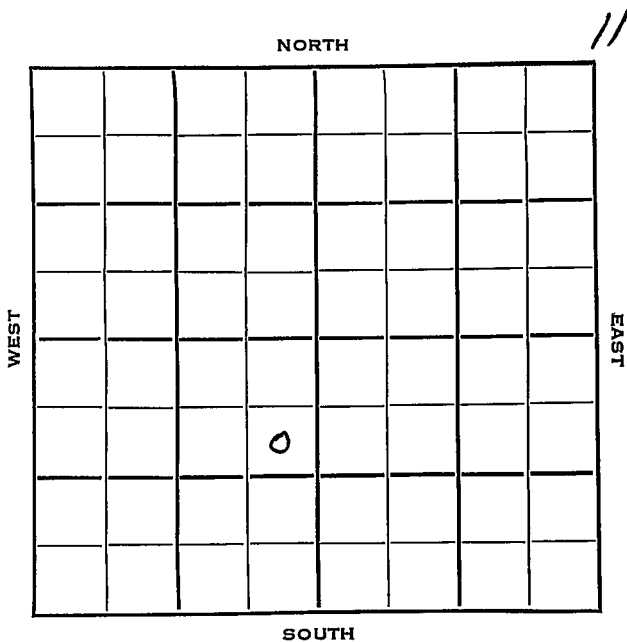

Russell KANSAS

SEC	TWP	R
10	11	11 W ✓
WELL NO		
# 5 Newcomer "C"		FARM
COMPANY		
B & R Drlg.		
CONTRACTOR		

990 _____ Ft from N Line
 _____ Ft from S Line
 330 _____ Ft from E Line
 _____ Ft from W Line

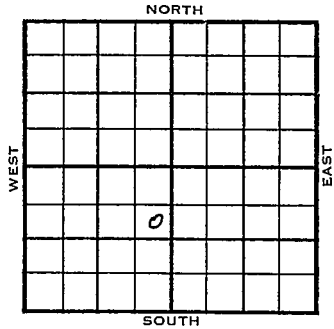

SE NE SW

1954	ELEVATION 1851'	REPORT
------	--------------------	--------

1/27 Spud 1-26-54
 2/3 8" @ 730' w/375 sks
 Anhy 847'
 Drlg. 2790'
 3/17 Spud 1-26-54
 Oil Well
 TD 3259'
 8" @ 730'
 Anhy 847', 1st Tarkio 2389', 2nd
 Tarkio 2410', Top 2705', Heeb 2938',
 Tor 2958', Doug 2973', Lans 2998'
 DST 3004-48', opn 1 hr., rec. 33'
 socm, Off
 Regan 3257'
 TD 3258'
 5" @ 3257'
 DD 3259
 FU 618' fluid 3 hrs.
 P/55 bopd
 Comp. 25 bopd

COMPLETED

