


Section 10 Township 14 Range 14 W

Well No. # 8 S. Boxberger

Company Stanolind

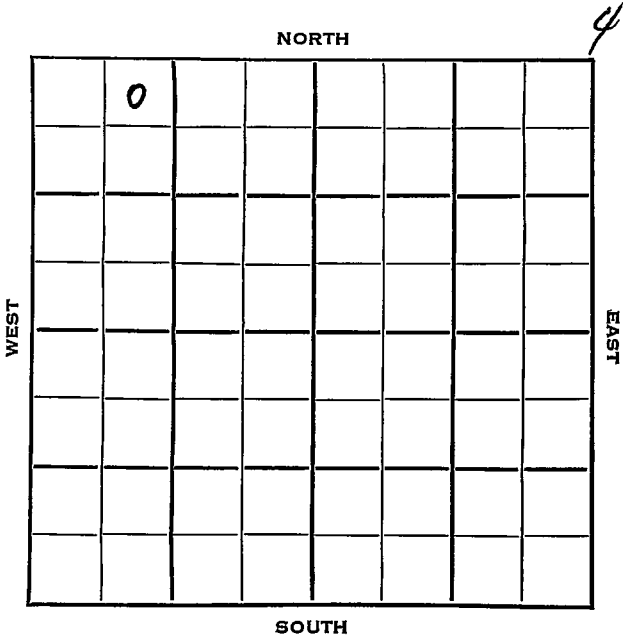

Russell

KANSAS

SEC

TWP

R.

10

14

14W

WELL NO

#8 S. Boxberger

FARM

COMPANY

Stanolind

CONTRACTOR

Hall-Gurney Pool

NORTH

330

Ft from N. Line

Ft from S. Line

Ft. from E Line

990


Ft from W Line

WEST

EAST

NE NW NW

SOUTH

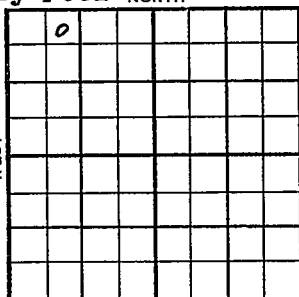

1953

ELEVATION

1830'

REPORT

10/21

Location

10/28

10" @ 830'

Drlg. 832'

11/4

Tarkio 2368' Lans 2979

DST 2981'-3004', 1 hr, 65' HOCM & SW
310# Drlg. 3057'

11/11

DST 3060-71, 1/2 hr, 5' M

RTD 3243' 7" @ 3242'

11/18

Regan 3241' CO 3243' 3 1/2 BOPH
& trace.

11/24

Spud 10-23-53

Oil Well

TD 3243'

10" @ 830'

Tarkio 2368, Lans 2979,

DST 2981'-3004' opr 1 hr, rec 65' hocm
& SW. 310#

DST 3060'-71' opn 1/2 hr, rec 5' Mud 15#

TD 3243'

7" @ 3242'

Regan 3241'

CO to 3243'

3 1/2 boph

Comp 35 bopd.

COMPLETED

County Russell State KansasSec. 10 (Blk. Twp.) 14 (Sur. Rge.) 14W Map No.Operator StanolindWell No. 8 Farm S. BoxbergerElev. Location NE NW NW

0							

330 Ft. From N Line NW990 Ft. From W Line Quarter1st. Report OCT 21 1953

Completion

Remarks

Spudding Date

Drlg. Data Hall-Gurney PoolLocation

J. G. McGEHEE

County Russell State KansasSec. 10 (Blk. 14) (Sur. 14W) Map No.Operator StanolindWell No. 8 Farm S. BoxbergerElev. 1830 Location NE NW NW

	o					

330 Ft. From N Line NW990 Ft. From W Line Quarter

1st. Report

Completion NOV 24 1953Remarks Hall-Gurney PoolSpudding Date 10-23-53Drig. Data Oil well TD 324310" @ 830 Tarkio 2368 Lans. 2979DST 2981-3004 open 1 hr. Rec. 65' hocom& SW 310# DST 3060-71 open $\frac{1}{2}$ hr.Rec. 5' mud 15# TD 3243 7" @ 3242Regan 3241 CO to 3243 3 $\frac{1}{2}$ bophComp. 35 bopd

O.W.W.O.

County Russell Elev. 1830
 Sec. 10 Twp. 11 Rge. 14W
 Company Pan American Pet.
 FarmName Roxberger No. 8

TOPS	DEPTH	LOG	DATUM
Anh.			
TP.			
H.			
Tr.			
Dg.			
BL.			
L.	2979		
K.C.			
B.K.C.			
Ce.			
C. Reagan	3213		
M.			
M.			
K.			
Mz.			
Mq.			
V.			
S.			
S.			
A.			
R.			
PE.			
G.			
T.D.			

Loc. in Sec.

NE NW NW

OWWO

Geol.

Contr.

Pool

0		
MAY 1	57	
FIRST REPORT		
COMPLETE		

Date Comm.

OTD 3213 7" @ 3212 PR 3225

8/ 2982-84 8/ 3021-23 8/ 3005-07

3000 A Comp. 13 bopd 14 bw