

KANSAS


Russell

FORM 51 5M PETROL

Section 10 Township 14 Range 14-W

Well No. #2 Sm Boxberger (Sam Boxberger)

Company Hartmen & Blair

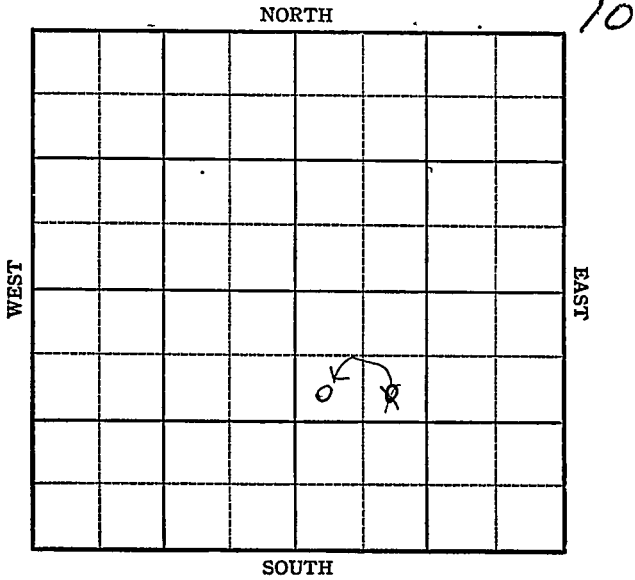

Sec. 10 Twp. 14 R. 14-W

Well No. #2 Sam Boxberger Farm

Hartman & Blair Company


990 Ft. from N. Line

_____ Ft. from S. Line

_____ Ft. from E. Line

330
~~990~~ Ft. from W. Line

Elev. 1849

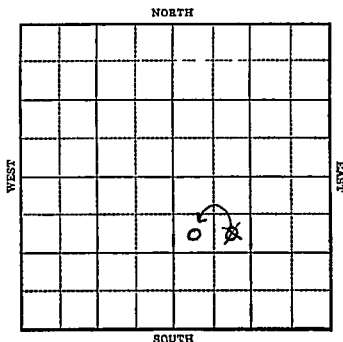

1943

R E P O R T

9/8	Location
9/15	Pits
9/22	"
9/29	"
10/6	"
10/13	Pits & cable rig material
10/20	" " " "
10/27	" " " "
11/3	" " " "
11/10	" " " "
11/17	15" @ 345; 13" @ 547' 10" @ 846' Anhy. 838-1130
11/24	Drlg. 1950'
12/1	8" @ 2400' Drlg. 2535'
12/8	Lans 2993 7" @ 2994 WOC.
12-15	TD 3204' 6000 acid Pump 19 1/2 oil per hr. 12 hrs

OVER

1943

12/22

7" @ 2994

Lans 2993

6000 acid

Pump 360 Pot.

TD 3024

Gravity 39.7

COMPLETED

KANSAS

Map No. 72 Sec. 10 Twp. 14 R. 14W

Well No. 2 Sam Bonberger

Hartman & Blair Company

FIRST REPORT Contractor

SE NW SE

990 Ft. from N. Line

_____ Ft. from S. Line

_____ Ft. from E. Line

990 Ft. from W. Line

SECTION PLAT

		o	

Witt Pool

Location X

Rig up _____

Drilling and Remarks:

RECORD

Cased _____ in., _____ ft.

Sand _____

Gas _____

Oil _____

Total Depth _____

PRODUCTION

1st 24 hrs. Nat. _____

1st 24 hrs. after shot _____

Gas _____ Cu. Ft.

Dry Hole _____

Abandoned _____

Date

SEP 8 1943 19 _____

S. J. LEWIS Scout

KANSAS

Map No. 72 Sec. 10 Twp. 14 R. 14W

Well No. 2 Sam Boxberger

Hartman & Blair Company

CORRECTION Contractor

SW NW SE

990 Ft. from N. Line

_____ Ft. from S. Line

_____ Ft. from E. Line

330 Ft. from W. Line

SECTION PLAT

Witt Pool

Location _____

Rig up _____

Drilling and Remarks:

*Reported
SE NW SE*

RECORD

Cased _____ in., _____ ft.

Sand _____

Gas _____

Oil _____

Total Depth _____

PRODUCTION

1st 24 hrs. Nat. _____

1st 24 hrs. after shot _____

Gas _____ Cu. Ft.

Dry Hole _____

Abandoned _____

Date

SEP 15 1943 19

S. J. LEWIS Scout

KANSAS

Map No. 72 Sec. 10 Twp. 14 R. 14W

Well No. 2 Sam Boxberger

Hartman & Blair Company

COMPLETED

Contractor

SW NW SE

SECTION PLAT

990 Ft. from N. Line

_____ Ft. from S. Line

_____ Ft. from E. Line

330 Ft. from W. Line

		0	

Witt Pool

Location _____

Rig up _____

Drilling and Remarks:

Lans 2993
7" @ 2994
6000 acid
Pump. 360 P.Y.

39 2 94

RECORD

Cased _____ in., _____ ft.

Sand _____

Gas _____

Oil _____

Total Depth 3024

PRODUCTION

1st 24 hrs. Nat. _____

1st 24 hrs. after shot _____

Gas _____ Cu. Ft.

Dry Hole _____

Abandoned _____

Date

DEC 22 1943

S. J. LEWIS

Scout