


Section 4 Township 29 Range 6E

Well No. #2 Selisch

Company Dunn - Strait

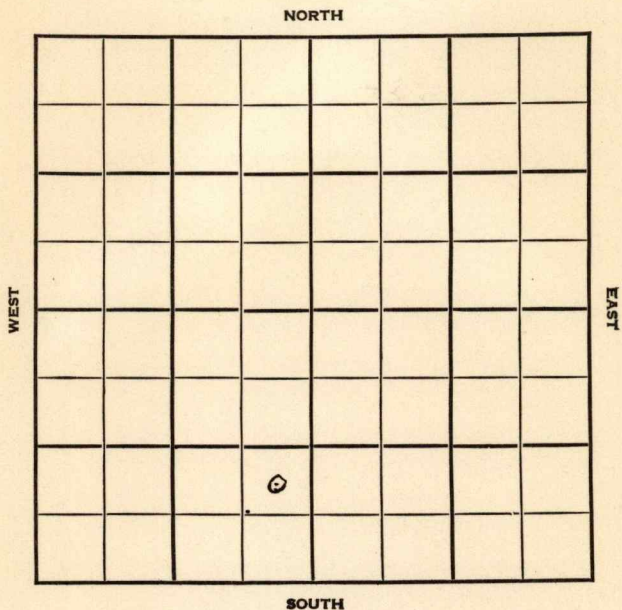

KANSAS

Butler



Sec. 4 Twp. 29 R. 6E

Well No. #2 Selisch Farm

Dunn - Strait Company


Misc.

 Ft. from N. Line

990 Ft. from S. Line

330 Ft. from E. Line

 Ft. from W. Line

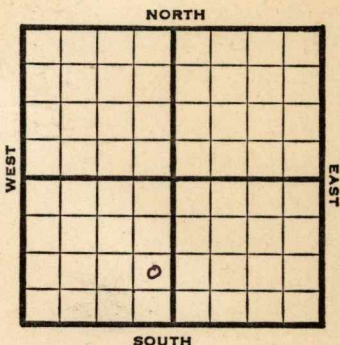

NE SE SW

1948

Elev. 1411' REPORT

- 1/28 Location
- 2/4 Mach.
- 2/11 "
- 2/18 S pud
- 2/25 13" @ 836'
Drlg. 910'
- 3/3 1650 Run 10"
- 3/10 Drlg. 2225'
- 3/17 Drg. 2695'
- 3/24 **Bart 2793'**
7" @ 2793'
Miss. 2815'
TD 2845'
PB 2814'
- 3/31 **Miss. 2815'**
7" @ 2793'
Bart. 2793'
PB 2814'
60 qts 2800-12
Pump 10 Pot.
Gr. 37.8°
TD 2845'

COMPLETED

Map No. _____ Sec. 4 Twp. 29 R. 6E

Well No. 2 Selisch

Dunn - Strait Company

FIRST REPORT

Contractor

NE SE SW

SECTION PLAT

_____ Ft. from N. Line
990 Ft. from S. Line
330 Ft. from E. Line
_____ Ft. from W. Line

Butler County

Location X

Rig up _____

Drilling and Remarks:

RECORD

Cased _____ in., _____ ft.
Sand _____
Gas _____
Oil _____
Total Depth _____

PRODUCTION

1st 24 hrs. Nat. _____
1st 24 hrs. after shot _____
Gas _____ Cu. Ft.
Dry Hole _____
Abandoned _____

Date

JAN 28 1948

19

S. J. LEWIS

Scout

